


Section 3 Township 26 Range 37-N
 Well No. #1 Waechter
 Company Helmerich & Payne

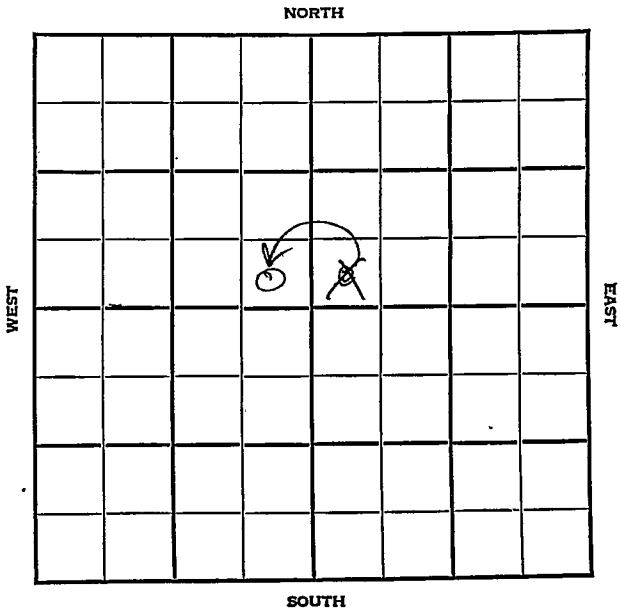

KANSAS

Kearny

Sec. 3 Twp. 26 R. 37EWell No. #1 Waechter Farm
Helmerich & Payne Company


Hugoton Pool

Ft. from N. Line

330' Ft. from S. Line330' Ft. from E. Line330' Ft. from W. Line

SE NW

SW NE

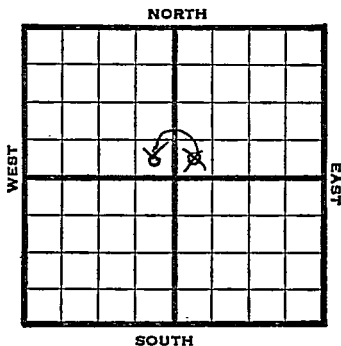

1948

Elev. 3046' REPORT

7/21 Location

7/28 10" @ 550'
Drlg 1850'8/4 TD 2350'
7" @ 2349'8/11 "
8/18 2407' 3000 acid8/25 TD 2561'
14000 acid

9/1 "

9/8 TD 2561'
7" @ 2349'
200' of 5" Perf Liner 2561
17,000 acid
Gas 19,482,000
R. Pr. 410#**COMPLETED**

Map No. _____ Sec. 3 Twp. 26 R. 37W

Well No. 1 Waechter

Helmerich & Payne Company

FIRST REPORT

Contractor

SW NE

SECTION PLAT

_____ Ft. from N. Line

330 Ft. from S. Line

_____ Ft. from E. Line

330 Ft. from W. Line

Kearny County

Location X

Rig up _____

Drilling and Remarks:

RECORD

Cased _____ in., _____ ft.

Sand _____

Gas _____

Oil _____

Total Depth _____

PRODUCTION

1st 24 hrs. Nat. _____

1st 24 hrs. after shot _____

Gas _____ Cu. Ft.

Dry Hole _____

Abandoned _____

Date

JUL 21 1948 19 S. J. LEWIS Scout

Kearny County Kansas StateMap No. _____ Sec. 3 Twp. 26 R. 37WWell No. 1 WaechterHelmerich & Payne CompanyCORRECTION Contractor

SE NW

SECTION PLAT

_____ Ft. from N. Line

330 Ft. from S. Line330 Ft. from E. Line

_____ Ft. from W. Line

Hugoten Pool

Remarks:

Reported SW NE

Date

JUL 28 1948

Scout

S. J. LEWIS

Kearny County Kansas State

Map No. Sec. 3 Twp. 26 R. 37W

Well No. 1 Waechter

Helmerich & Payne Company


COMPLETE

Contractor

SE NW

E1.3046

SECTION PLAT

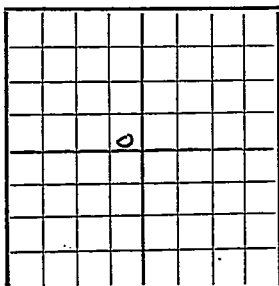

Ft. from N. Line

330 Ft. from S. Line

330 Ft. from E. Line

Ft. from W. Line

Hugoton Pool

Remarks:

7152561
 7' @ 2349
 200' of 5" Prof. line 2561
 17000 acc
 19,482,000 Gall
 410th R/P₂

Date
SEP 8 1948

Scout S. J. LEWIS