


Section 30 Township 26 Range 39W

Well No. #1 L. G. Hattrup

Company United Production

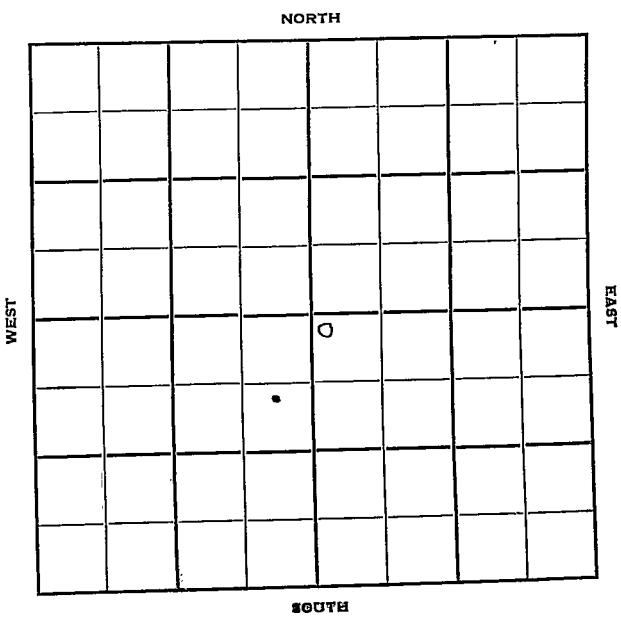


Sec. 30 Twp. 26 R. 39W

Well No. #1 L. G. Hattrup Farm

United Production Company

Stovall Drlg. - Contr. Contractor

150' Ft. from N. Line
 Ft. from S. Line
 Ft. from E. Line
150' Ft. from W. Line

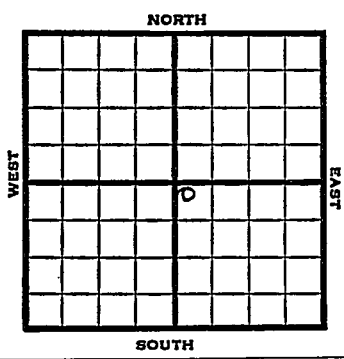

NW SE

1951 Elev. 3332' REPORT

8/15 Location

10/3 Spud 8-14-51
Gas well TD 2545' 10" @ 540'
7" @ 2478' TD 2545' Her. 2473'
Kri 2484' Win. 2527'
32,000 A
Comp. 16,800,000 gas 404#

COMPLETED

