

Finney


KANSAS

SECTION 30 TOWNSHIP 26 RANGE 34W

WELL NO. #1 Devlin-Jones

COMPANY Helmerich & Payne

NORTH

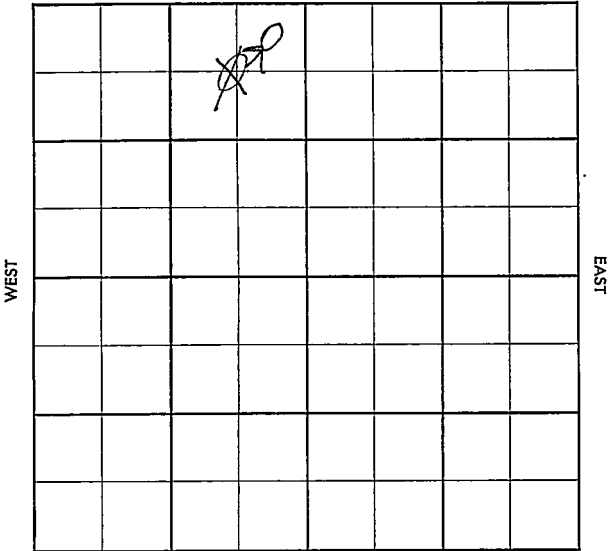

SOUTH

WEST

EAST

CORRECTION

FORM 513 SUNRAY

County Finner Elev. 3013
 Sec. 30 Twp. 26 Rge. 31W
 Company Helmerich & Payne
 Farm Name Devlin-Jones No. 30-1

TOPS	DEPTH	LOG	DATUM
Anh.			
Top	3447	3453	
H.	3872	3873	
Tr.	3886	3885	
Dg.			
Bl.			
L.	3916	3916	
K.C.			
B.K.C.		4471	
Ce.			
C.	Marm	4491	
M.	ce	4637	
M.	Atoka	4854	
K.	Mwsh	4918	
Mz.	" sd	4996-5001	
Mo.	MISS-STAN	5022	-1300
V.	ST LOUIS	5042	-0240
S.			
S.			
A.			
R.			
PE.			
G.			
T.D.	5167		

Loc in Sec. 4 NE NW
NE

Geol. _____
 Contr. _____
 Pool _____
 NW Pleasant Prairie

0		
MAY 15 '57		
COMPLETE		

Date Comm. _____
 Location JAN 23 '57 JAN - 26 - 56
10 3/4 @ 765 1425 WOC FEB 6 '57
10 3412 FEB 13 '57 10 Fshg @ 4271
FEB 20 '57 CR9 @ 5045 FF 21'S CRD
5010-45 rec 35' (S.O.) CRD 5045
-95 rec 50' CRD 5095-5145 rec
50' 5 1/2 5165/600 MAY 15 '57 CO 24/
5136-42 N.S. 1/2 N.S. PB 5123
76/5090-5109 PB 16 Goph 20/W

Co. Use. No. Sec. T. R.

$\frac{1}{2}$ \$ 35 Boph. PB 5880
 72/5052-72 $\frac{1}{2}$ \$ 8 B0 in
 12 hrs CO 5125 5.1 HAN
 APR 17 '57 APR 24 '57 APR 1 57 Pof Ar 57
 APR 17 '57 APR 24 '57 MAY 1 '57 MAY 5 '57

B17 Bumb P. 123 Bapd N/W
 24 hrs