


Section 30 Township 26 Range 34W

Well No. 5 ~~Pldg. & Loan~~ JONES

Company Helmerich & Payne

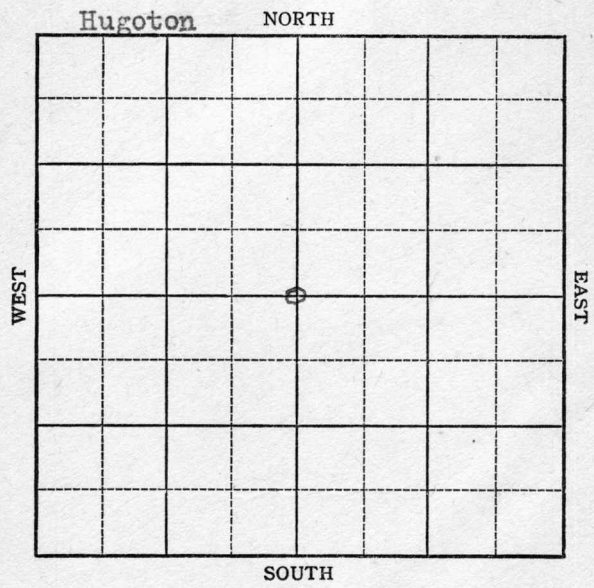

Sec. 30 Twp. 26 R. 34W

Well No. #5 Bldg. & Loan JONES Farm

Helmerich & Payne Company

Hugoton


2640 Ft. from N. Line

 Ft. from S. Line

2640 Ft. from E. Line

 Ft. from W. Line

C Sec.

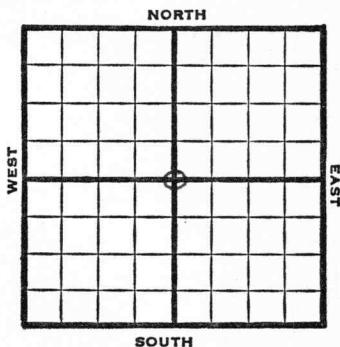

1947	REPORT
7/23	RUR
7/30	TD 2575' 5" @ 2552' RUST
8/6	10" @ 784' TD 2640' 200 acid.
8/13	TD 2727 - 12000 acid
8/20	3000 Acid
8/27	"
9/3	"
9/10	"
9/17	"
9/24	"
10/1	"

OVER

1947

10/8 7" @ 2552
15,000 Acid
2,906,000 Gas
TD 2727'
418# R Pr.

COMPLETED

Kansas

Map No. _____ Sec. 30 Twp. 26 R. 34WWell No. 5 Bldg. & Loan

_____ Helmerich & Payne _____ Company

_____ FIRST REPORT _____ Contractor

C Sec.


SECTION PLAT

2640 Ft. from N. Line

_____ Ft. from S. Line

2640 Ft. from E. Line

_____ Ft. from W. Line

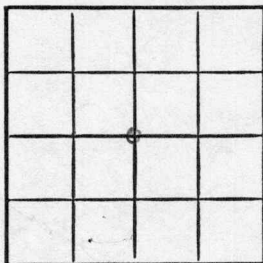

Finney County

Location _____

Rig up _____

Drilling and Remarks: _____

R U R

RECORD

Cased _____ in., _____ ft.

Sand _____

Gas _____

Oil _____

Total Depth _____

PRODUCTION

1st 24 hrs. Nat. _____

1st 24 hrs. after shot _____

Gas _____ Cu. Ft.

Dry Hole _____

Abandoned _____

Date


JUL 23 1947

19

S. J. LEWIS

Scout

SECTION PLAT

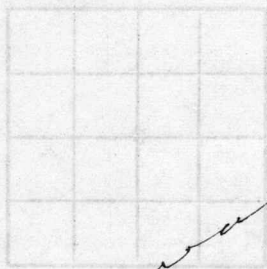

RECORD

Misc. Small Maps	
Cards	<u>RFB.</u>
Tracing	
France Map	
Scarborough Map	☒
Pierce Map	
Ceological Dept.	
Pierce Flat Book	

Map No. 0 Sec. 30 Twp. 26 R. 34W

Well No. 5 Jones

Helmerich & Payne Company

CORRECTION Contractor

C Sec.


SECTION PLAT

2640 Ft. from N. Line

 Ft. from S. Line

2640 Ft. from E. Line

 Ft. from W. Line

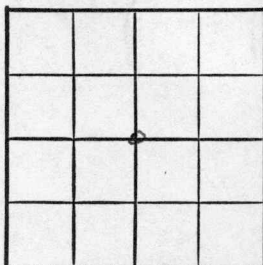

Finney County

Location

Rig up

Drilling and Remarks:

Reported

#5 Bldg. & Loan

RECORD

Cased in., ft.

Sand

Gas

Oil

Total Depth

PRODUCTION

1st 24 hrs. Nat.

1st 24 hrs. after shot

Gas Cu. Ft.

Dry Hole

Abandoned

Date

JUL 30 1947

19

S. J. LEWIS

Scout

Map No. 0 Sec. 30 Twp. 26 R. 34W

Well No. 5 Jones

Helmerich & Payne


Company

COMPLETE

Contractor

C Sec.

SECTION PLAT

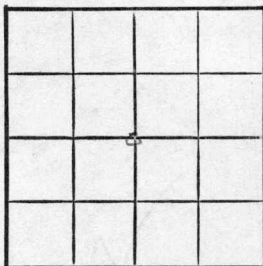

2640 Ft. from N. Line

 Ft. from S. Line

2640 Ft. from E. Line

 Ft. from W. Line

Finney County

Location

Rig up

Drilling and Remarks:

7 "C2532

15000 Prod

2,906,000 Gas

418# R/B

RECORD

Cased in., ft.

Sand

Gas

Oil

Total Depth 2727

PRODUCTION

1st 24 hrs. Nat.

1st 24 hrs. after shot

Gas Cu. Ft.

Dry Hole

Abandoned

Date

OCT 8 1947 19

S. J. LEWIS

Scout

Map No. _____ Sec. _____ Twp. _____ R. _____


Well No. _____

Company _____

Contractor _____

COMPLETE

SECTION PLAT

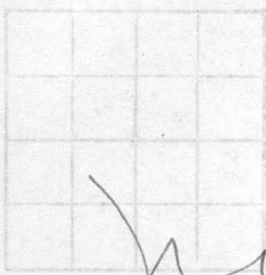

_____ Ft. from N. Line

_____ Ft. from S. Line

_____ Ft. from E. Line

_____ Ft. from W. Line

RECORD

Cased _____ in _____
 Sand _____
 Gas _____
 Oil _____
 Total Depth _____

Location _____

Rig up _____

Drilling and Remarks _____

Misc. Small Maps	_____
Cards	<i>Chaine</i>
Tracing	☒
France Map	☒
Seaborough Map	☒
Pierce Map	☒
Ceological Dept.	_____
Pierce Flat Book	_____

Date _____