


DX 78-1 Finney

KANSAS

Section 30 Township 26 Range 34W

Well No. #1-30 U.S.

Company Helmerich & Payne

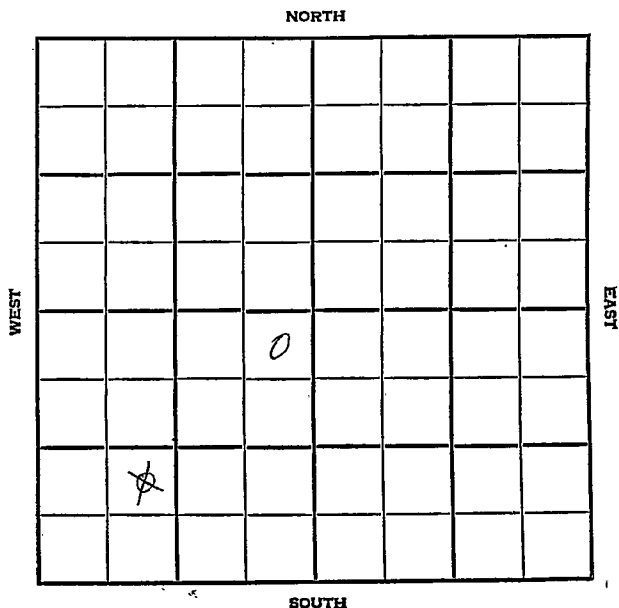

CORRECTION

FORM 513 SUNRAY

County Finney Elev. 3024
 Sec. 30 Twp. 26 Rge. 34W
 Company Helmerich & Payne -
 Farm Name U.S. No. 1-30

TOPS	DEPTH	LOG	DATUM	Loc. in Sec.
Anh.				NE SW SW
TP.	3413			NENE SW
H.	3850	3855		
Tr.				
Dg.				
Bl.				
L.	3889	3924		Geol.
K.C.				Contr.
B.K.				McKnab &
Co.	Marm	4434	4508	Lindsay.
Co.			4650	Pool
M.	MWSH	4920	4967	Hugoton
M.		5022?	5001	
K.				
Mz.				
Mo.				
V.				
S.				
Sc.				
A.				
R.				
RE.				
G.				
TD.				

COMPLETE

JAN 9 '57

Date Comm.

Location AUG 22 '56 AUG 29 '56 SEP 5 '56 SEP 12 '56

SEP 19 '56 ✓ SEP 26 '56 OCT 3 '56 OCT 10 '56 OCT 17 '56
 OCT 24 '56 ✓ OCT 31 '56 10 - 23 - 52 10" 56

@ 872/550 D 2852 NOV 7 '56

D 4040 NOV 13 '56 DST 3940-4055

70" rec 900' MSW + 1140' 80' p w h

FP 220-850 DHP 1040/20

DST 4124-4210 1 hr rec 5' 0 CM

+ 70' oil + 1040 408 GC SW

+ 630' MSW. FP 130-760 BHP
1210/200 PTD 456P NOV 21 '56

DST 4947-74 1hr 90' ocm
FP 20-75 BHP 130/20"

DST 5004-26 op 30" no res
FP 40-40 BHP 60/30" DST
5035-98 30" res 5' Md
(5066) BHP 0/30" 5120

DEC 28 '56 * DST 5122-64 op 90"
0.75" TSTM res 1260' clean oil

+ 276' H68 ocm FP 50-510 BHP
1325/30" RTD 5278 7" C 5210/700

MICF DEC 5 '56 C 5181 24/5168
- 24 550 1/2" * 376 Bp in 24

hr. RD 14.7 Boph. gran
32.4 4 10 5168 5125-42 16

Boph. 5 hr T&R DEC 12 '56 POP
DEC 18 '56 P 44 Bopd no/wtr.

DEC 26 '56 wo st test. JAN 2 '57

JAN 9 '57 Ph P. 200 Bopd no/wtr
gran 33.6°