


Section 32 Township 26 Range 31 W

Well No. #1 Main

Company Michaelis Drlg.

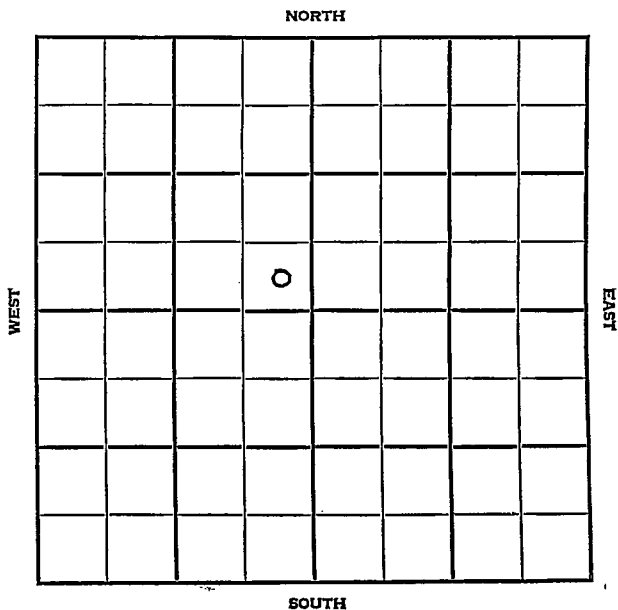

Finney

KANSAS

SEC.	TWP.	R..
32	26	31W

WELL NO.

#1 Main

FARM

COMPANY

Michaelis Drlg Co.

CONTRACTOR

Co. Tools

Hugoton


Ft. from N. Line

300' Ft. from S. Line

300' Ft. from E. Line

Ft. from W. Line

SE SE N W

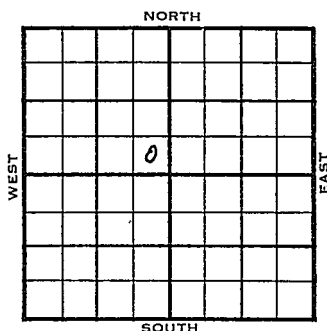

1955

ELEVATION

2821'

REPORT

10/5

Comm 10-2-55

8" @ 519/300

Drlg

11-16

5½" @ 2699/300

CO. to 2674

40/ 2660-70,

40/ 2638-48

frac 3,186 mcfg 9 hr.

Comp. 8,131 mcfgpd

Tops: Her. 2608

U. Kri 2636

L. Kri. 2661

TD 2700'

COMPLETED

County Finney Elev. _____
 Sec. 32 Twp. 26 Rge. 31W
 Company Michell's Drlg.
 FarmName Main No. 1

Co.

Lse.

No.

Sec.

T.

R.

TOPS	DEPTH	LOG	DATUM	Loc. in Sec.
Anh.				SE SE NW
Ip.				300' SL
H.				300' EL
Tr.				Geol.
Dg.				Contr.
BL.				Co. tools
L.				Pool
K.C.				Hugoton
B.K.C.				
Ce.				
C.				
M.				
M.				
K.				
Mz.				
Ma.				
V.				
S.				
S.				
A.				
R.				
Pe.				
G.				
T.D.				

OCT 5 '55

FIRST REPORT

Date Comm. 10-2-558" @ 519/300 drlg.

34

County Finney Elev. 2821
 Sec. 32 Twp. 26 Rge. 31W
 Company Michaelis Drlg.
 Farm Name Main No. 1

TOPS //	DEPTH	LOG	DATUM	Loc. in Sec.
Anh.				SE SE NW
Tp. <u>West</u>	<u>2608</u>			
H. <u>U. K. R.</u>	<u>2636</u>			300' SL
Tr. <u>L. K. R.</u>	<u>2661</u>			300' EL
Dg.				
Bl.				
L.				Geol.
K.C.				Contr.
B.K.C.				Co. tools
Ce.				
C.				Pool
M.				Hugoton
M.				
K.				
Mz.				
Mq.				
V.				
S.				
S.				
A.				
R.				
Pc.				
G.				
T.D.	<u>2700</u>			

Date Comm. 10-2-55 NOV 16 1955

8" @ 519/300 5 $\frac{1}{2}$ " @ 2699/300 CO to

2674 40/ 2660-70 40/ 2638-48

frac 3,186 mcf g 9 hr.

Comp. 8,131 mcf gpd