


DX 78-1

Section 30 Township 26 Range 31 W
Well No. #1 Masoner Unit
Company Michaelis Drlg. et al

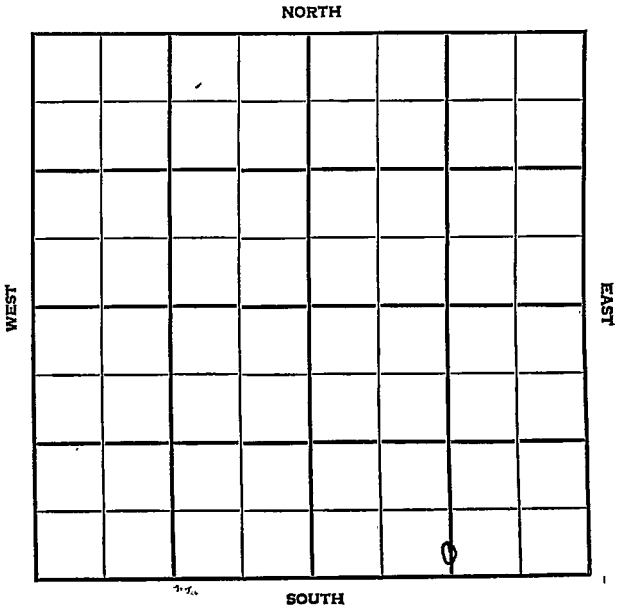

Finney		KANSAS	
SEC.	TWP.	R.	
30-	26S	31W	

WELL NO.	
#1 Masoner Unit	FARM
COMPANY	
Michaelis Drlg. et al	
CONTRACTOR	

Hugoton


_____ Ft. from N. Line

300 _____ Ft. from S. Line

1330' _____ Ft. from E. Line

_____ Ft. from W. Line

S/2 S/2 SE

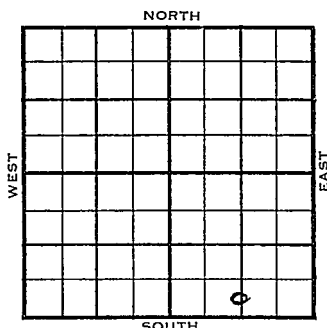

FIRST REPORT

1955	ELEVATION	REPORT
	2844	
7/13	Spud 7/10/55 8" 529 w/300 D 1350	
8/10	Comm 7-10-55 Tp Herr 2626 U Kri 2654 Tr L Kri 2680 TD 2716 8" @ 529/300 5 1/2" @ 2715/300 CO to 2697 40/2678-88 frac 88/2642-64 frac 2,960,000 cfg Comp 7,600 mcf/gpd	

COMPLETED

County Finney Elev. _____
 Sec. 30 Twp. 26S Rge. 31W
 Company Michaelis Drlg., etal
 Farm Name Masoner Unit No. 1

TOPS	DEPTH	LOG	DATUM	Loc. in Sec.
Anh.				S/2 S/2 SE
TP.				1330' FE ₂ x 300
H.				FSL of Sect.
Tr.				Geol.
Dg.				Contr.
BL.				
L.				
K.C.				
B.K.C.				
Ce.				
C.				
M.				
M.				
K.				
Mz.				
Mq.				
V.				
S.				
S.				
A.				
R.				
PE.				
G.				
T.D.				

Pool Hugoton

JUL 13 '55

FIRST REPORT

Date Comm. spd 7/10/55 8" 529 W/300 D1350

35

County Finney Elev. 2811Sec. 30 Twp. 26 Rge. 31WCompany Michaelis Drlg. etal.FarmName Masoner Unit No. 1

TOPS	DEPTH	LOG	DATUM	Loc. in Sec.
Anh.				
Tp. <u>Hart</u>		<u>2626</u>		<u>C S$\frac{1}{2}$ S$\frac{1}{2}$ SE</u>
H. <u>L. Kri</u>		<u>2654</u>		<u>300' SL</u>
Tr. <u>L. Kri</u>		<u>2680</u>		<u>1330' EL</u>
Dg.				
BL.				
L.				
K.C.				Geol. _____
B.K.C.				Contr. _____
Ce.				
C.				
M.				
M.				Pool _____
K.				<u>Hugoton</u>
Mz.				
Mq.				
V.				
S.				
S.				
A.				
R.				
PE.				
G.				
T.D.	<u>2716</u>			

COMPLETE

AUG 10 1955

Date Comm. 7-10-558 1/2" @ 529/300 5 1/2" @ 2715/300CO to 2697 10/ 2678-88 frac88/ 2642-64 frac 2,960,000 c fgComp. 7,600 mcf gpd