

Finney


KANSAS

SECTION 4 TOWNSHIP 26 RANGE 31W

WELL NO. #1 McGraw

COMPANY Graham Michaelis Drlg.

NORTH

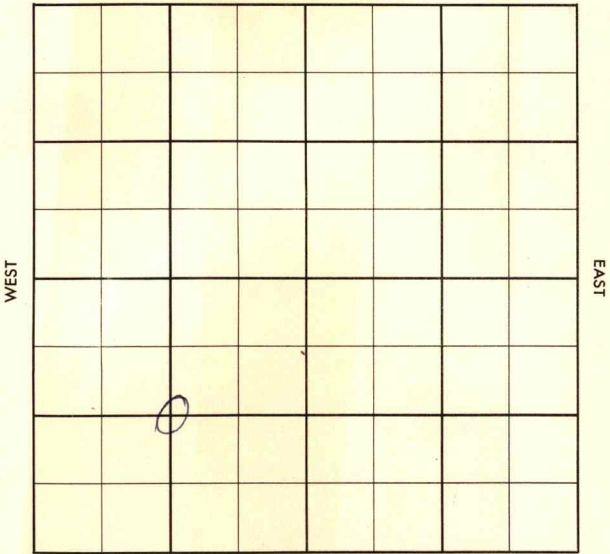

SOUTH

County Finney

Elev. _____

Sec. 4Twp. 26Rge. 31WCompany Graham Michaelis Drlg.Farm Name McGrawNo. 1

TOPS

DEPTH

LOG

DATUM

Loc. in Sec. _____

Anh. _____

Tp. _____

H. _____

Tr. _____

Dg. _____

Bl. _____

L. _____

K.C. _____

B.K.C. _____

Ce. _____

C. _____

M. _____

M. _____

K. _____

Mz. _____

Me. _____

V. _____

S. _____

S. _____

A. _____

R. _____

P.E. _____

G. _____


T.D. _____

Geol. _____

Contr. _____

Pool _____

Semi-Wildcat

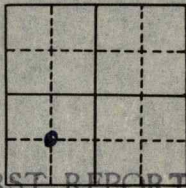

FIRST REPORT

Date Comm. _____

Phillips FO

Drlg. @ 2429 OCT 10 '56

2201 A.S. 100

Co.

Lse.

No.

Sec.

T.

R.

County Finney Elev. 2822
 Sec. 4 Twp. 26 Rge. 31W
 Company Graham Michaelis Drlg.
 Farm Name McGraw No. 1

TOPS	DEPTH	LOG	DATUM	Loc. in Sec.
Anb. <u>Hart</u>		<u>2603</u>		<u>C SW/4</u>
Tp. <u>4 KFI</u>		<u>2609</u>		
H. <u>4 KFI</u>		<u>2651</u>		
Tr. <u>WFD</u>		<u>2700</u>		
Dg.				
Bl.				
L.				Geol.
K.C.				
B.K.C.				Contr.
Ce.				
C.				
M.				
M.				Pool
K.				
Mz.				Semi-Wildca
Mo.				
V.				
S.				
S.				COMPLETE
A.				
R.				
Pe.				
G.				
T.D.	<u>2709</u>			

Date Comm. 10-4 Phillips FO

Drlg. @ 2429 ^{OCT 17 '56} 8 5/8 500/300

4 1/2 2706/ ^{OCT 24 '56} MICT ^{OCT 31}

32/2632-40 48/2656-68 11

FRAC 9a 1,300 MCF 11 9a 1,900

MCF NOV 7 '56 72-20 9a 6,131

MCF RP 415 #