


DX 78-1 Finney

KANSAS

Section 8 Township 26S Range 31W

Well No. #1 Brensing

Company Kan-Nebraska

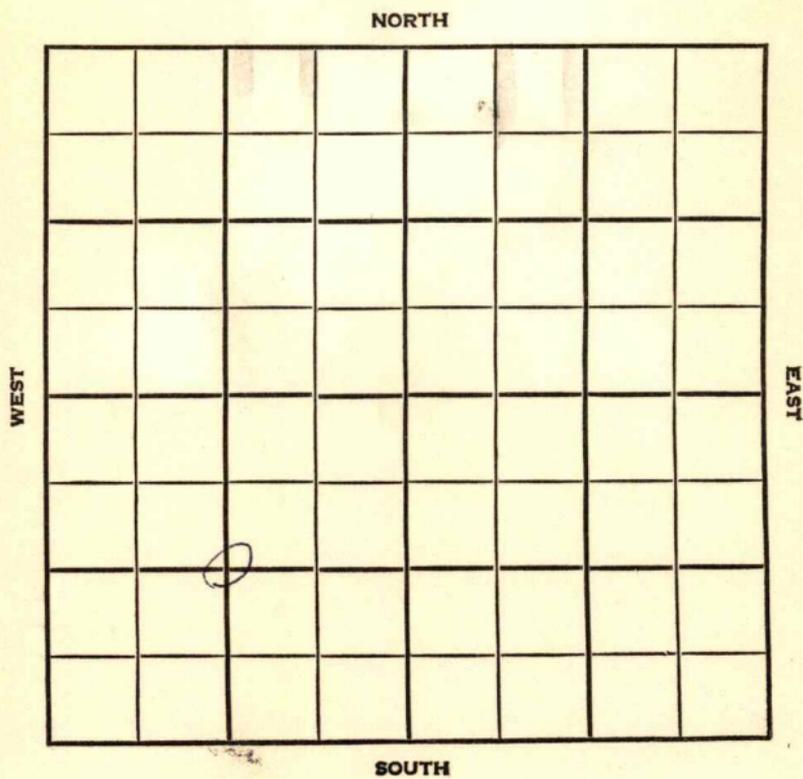

SEC. 8	TWP. 26S	R. 31W
-----------	-------------	-----------

WELL NO.

#1 Breusing

FARM

COMPANY

Kan-Nebraska

CONTRACTOR

Bennett & Roberts


Hugoton

_____ FT. FROM N. LINE

_____ FT. FROM S. LINE

_____ FT. FROM E. LINE

_____ FT. FROM W. LINE

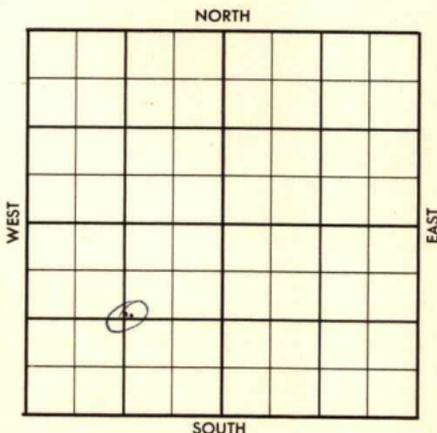

C SW/4

Champlin - FO

1956	ELEVATION 2825 DF	REPORT
------	----------------------	--------

7-25

Comm. 7-17-56
 8" @ 528 w/375
 RTD 2716'
 5 1/2" @ 2715 w/200
 Log.
 WOCT

8-22

CO 48/ 2666-78; 48/2692-2704
 S/ 800 GSWPH
 CO 2670 32/2658-66
 S/ 75 goph / SSG
 D & A
 Log tops: Herr. 2640'; Kri. 2675';
 TD 2716'

ABANDONED

County Finney Elev. 2825 DF
 Sec. 8 Twp. 26S Rge. 31W
 Company Kan-Nebraska
 Farm Name Erensing No. 1

TOPS	DEPTH	LOG	DATUM	Loc. in Sec.
Anh <u>Herr</u>		<u>2640</u>		<u>C SW/4</u>
Tr. <u>KPI</u>		<u>2672</u>		
H.				
Tr.				
Dg.				
Bl.				
L.				
K.C.				Geol. _____
B.K.C.				Contr. <u>Bennett</u>
Ce.				& <u>Roberts</u>
C.				
M.				Pool _____
M.				<u>Hugoton</u>
K.				
Mz.				
Ma.				
V.				
S.				
S.				
A.				
R.				
Pe.				
G.				
T.D.	<u>2716</u>			ABANDONED AUG 22 1956

Date Comm. 7/17/56 Champlin - FO

8" 528 w/375 RTD 2716 5 1/2" 2715 w/200

Log. WOCT AUG 1 '56 W OCT AUG 8 '56

AUG 15 '56 AUG 22 '56 W CO 48/2666-78

48/2692-2704 FRAC @ 800 GSWP

59d CO 2670 32/2658-66 A


@ 75 goph + 55G

D&A

County Pinney Elev. _____
 Sec. 8 Twp. 26 Rge. 31W
 Company Kans. Nebr.
 Farm Name Brensing No. 1

TOPS	DEPTH	LOG	DATUM
Anh.			
TP.			
H. <u>Herr.</u>	<u>2658</u>		
Tr. <u>Kri</u>	<u>2686</u>		
Dg.			
Bl.			
L.			
K.C.			
B.K.C.			
Ce.			
C.			
M.			
M.			
K.			
Mz.			
Me.			
V.			
S.			
S.			
A.			
R.			
PE.			
G.			
T.D.	<u>2716</u>		

Loc. in Sec. C SW 1/4
 Geol. _____
 Contr. _____
 Pool _____
Hugoton

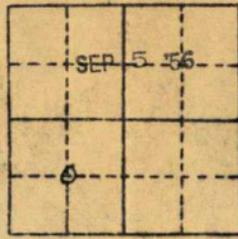

Date Comm. 7/17/56
8" @ 548 w/275, Herr 2658, Kri 2686, STD
2716, 5" @ 2715 SEP 5 '56

Duplication

Co.
 Lse.
 No.
 Sec.
 T.
 R.

County **Finney** Elev. _____
 Sec. **8** Twp. **26S** Rge. **31W**
 Company **Kan-Nebraska**
 Farm Name **Bremsing** No. **1**

TOPS	DEPTH	LOG	DATUM
Anh.			
Ip.			
H.			
Tr.			
Dg.			
BL.			
L.			
K.C.			
B.K.C.			
Ce.			
C.			
M.			
M.			
K.			
Mz.			
Mq.			
V.			
S.			
S.			
A.			
R.			
PE.			
G.			
T.D.			

Loc. in Sec. **C SW/4**
 Geol. _____
 Contr. **Bennett & Roberts**
 Pool **Hugoton**

FIRST REPORT
 JUL 25 1956

Date Comm. **7/17/56** **Champlin - FO**
8ⁿ 528 w/375 RTD 2716 5¹/₂ⁿ 2715 w/200
 Log. **WOCT**

Handwritten red scribbles and marks

Handwritten red scribbles and marks

Co.
Lse.
No.
Sec.
T.
R.

Well
D+H
TD 2116


County Finney Elev. _____
Sec. 8 Twp. 26 Rge. 31W
Company Kans. Nebr.
FarmName Brensing No. 1

TOPS	DEPTH	LOG	DATUM
Anh.			
TP.			
H.			
Tr.			
Dg.			
Bl.			
L.			
K.C.			
B.K.C.			
Ce.			
C.			
M.			
M.			
K.			
Mz.			
Me.			
V.			
S.			
S.			
A.			
R.			
PE.			
G.			
T.D.			

Loc. in Sec. C SW /4

Geol. _____
Contr. _____

Pool Hugoton

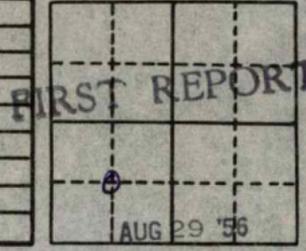

Date Comm. 7/17/56
8" @ 548 w/275, Herr 2658, Kri 2686, RTD
2716, 5" @ 2715

35

219 2 1956

D.R.

Co.
Lse.
No.
Sec.
T.
R.

~~Well~~ D+A here
TD 2716

Well shown on map here as dry hole
at TD 2716'. Is this a twin to
this dry hole or is this a work over?
Please advise.

Sam

This is one and the same well. It was
first reported again by error.

SEP 5 1956

R. G.