

Finney


KANSAS

SECTION 9 TOWNSHIP 26 RANGE 31 W

WELL NO. #1 Keller "B"

COMPANY Michaelis Drlg. & Oil Trading

NORTH

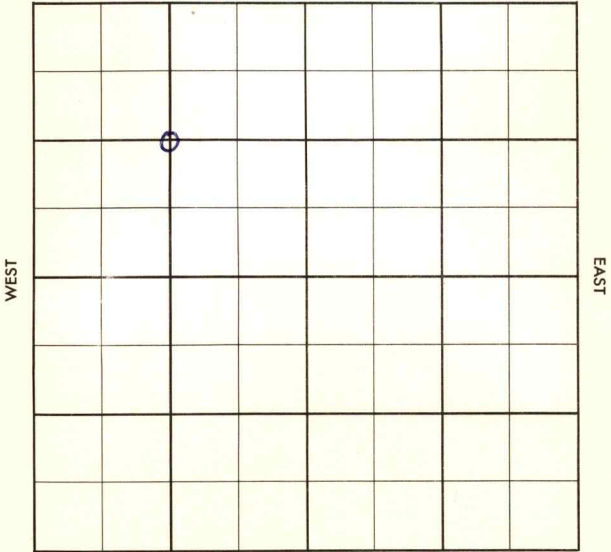

SOUTH

Finney

KANSAS

SEC.	TWP.	R.
9	26	31W

WELL NO.

#1 Keller "B"

FARM

COMPANY

Michaelis Drlg. & Oil Trading

CONTRACTOR

Co. Tobls

Hugoton


_____ Ft. from N. Line

_____ Ft. from S. Line

_____ Ft. from E. Line

_____ Ft. from W. Line

C NW/4

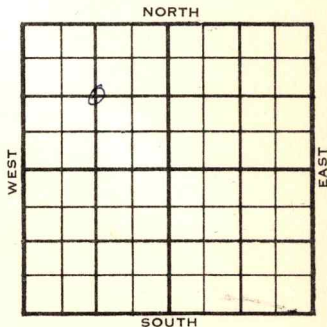

1956	ELEVATION	REPORT
------	-----------	--------

1-25

Location

