

Finney


KANSAS

SECTION 16 TOWNSHIP 26 RANGE 31 W

WELL NO. #1 Vandarree

COMPANY Michaelis Drlg.

NORTH

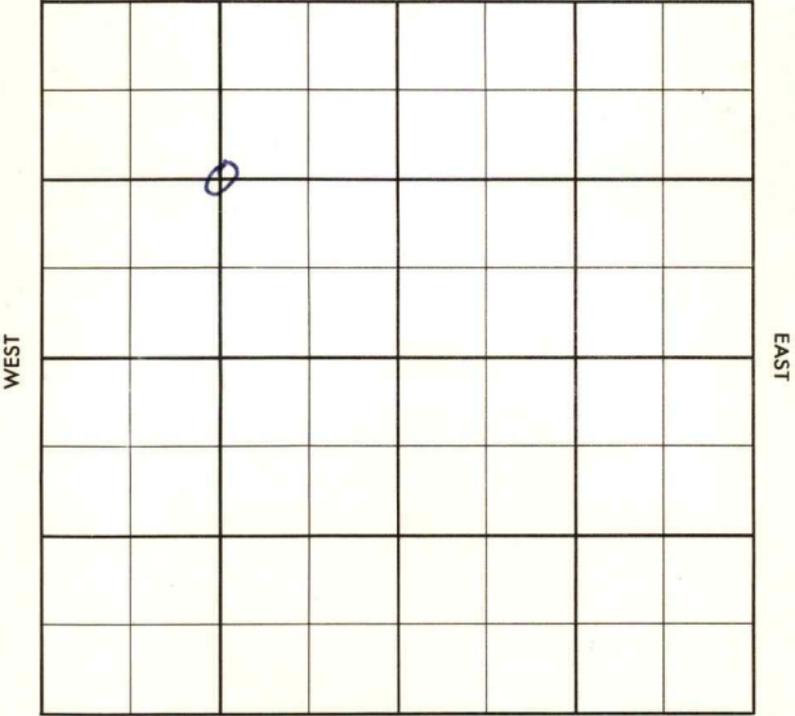

SOUTH

Finney

KANSAS

SEC. 16	TWP. 26	R. 31W
------------	------------	-----------

WELL NO. #1 Vandarree FARM

COMPANY Michaelis Drlg

CONTRACTOR Co Tools


Hughton

_____ Ft. from N. Line

_____ Ft. from S. Line

_____ Ft. from E. Line

_____ Ft. from W. Line

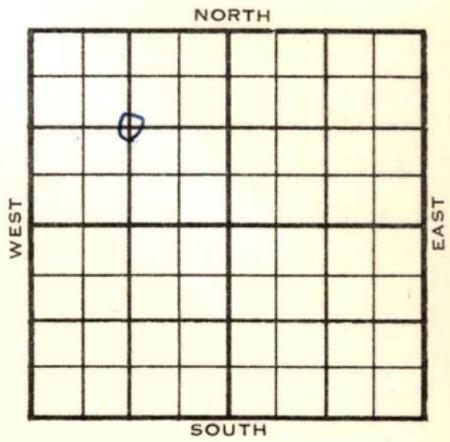

C NW/4

Mid-States FO

1955	ELEVATION 2816'	REPORT
------	--------------------	--------

11/2 M I R


12-7 Comm. 11-1-55
 8 5/8" @ 507/300
 4 1/2" @ 2677/400
 CO to 2663, 48/ 2650-62, 40/ 2626-36
 frac, 3 mcfg,
 Comp. 7,326 mcfgpd, ~~###~~ 440#
 Herr 2599
 Kri 2625
 TD 2678'

COMPLETED

County Finney Elev. _____
 Sec. 16 Twp. 26 Rge. 31W
 Company Michaelis Drlg.
 Farm Name Vandarree No. 1

TOPS	DEPTH	LOG	DATUM	Loc. in Sec.									
Anh.				C NW/4									
Tr.													
H.													
Tr.													
Dg.													
Bl.													
L.				Geol. _____									
K.C.				Contr. _____									
B.K.C.													
Ce.				Co tools									
C.													
M.				Pool									
M.				Hugoton									
K.				<table border="1"> <tr> <td></td> <td></td> <td></td> </tr> <tr> <td></td> <td>NOV 2 '55</td> <td></td> </tr> <tr> <td></td> <td></td> <td></td> </tr> </table>					NOV 2 '55				
	NOV 2 '55												
Mz.													
Ma.													
V.													
S.													
S.													
A.													
R.													
Pe.													
G.													
T.D.													

Date Comm. Mid-States farmout
M I R

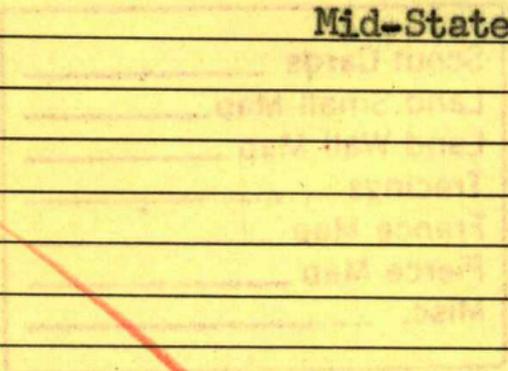

35

Co.
Lse.
No.
Sec.
T.
R.

County Finney Elev. 2816
 Sec. 16 Twp. 26 Rge. 31W
 Company Michaelis Drlg.
 Farm Name Vandarree No. 1

Co.
Lse.
No.
Sec.
T.
R.

TOPS	DEPTH	LOG	DATUM
Anh. <u>Herr</u>		<u>2599</u>	
T.P. <u>Kri</u>		<u>2625</u>	
H.			
Tr.			
Dg.			
BL.			
L.			
K.C.			
B.K.C.			
Ce.			
C.			
M.			
M.			
K.			
Mz.			
Me.			
V.			
S.			
S.			
A.			
R.			
PE.			
G.			
T.D.	<u>2628</u>		

Loc. in Sec. C NW/4
 Geol. _____
 Contr. _____
 Co. tools _____
 Pool Hugoton



DEC 7 1955

Date Comm. 11-1-55

8 5/8" @ 507/300 4 1/2" @ 2677/400
CO to 2663 48/ 2650-62 40/ 2626-36
frac 3 mcfg Comp. 7,326 mcfgpd 440#