


SECTION 17 TOWNSHIP 26 RANGE 31W

WELL NO. # 2 Brensing

COMPANY Kansas-Nebr.

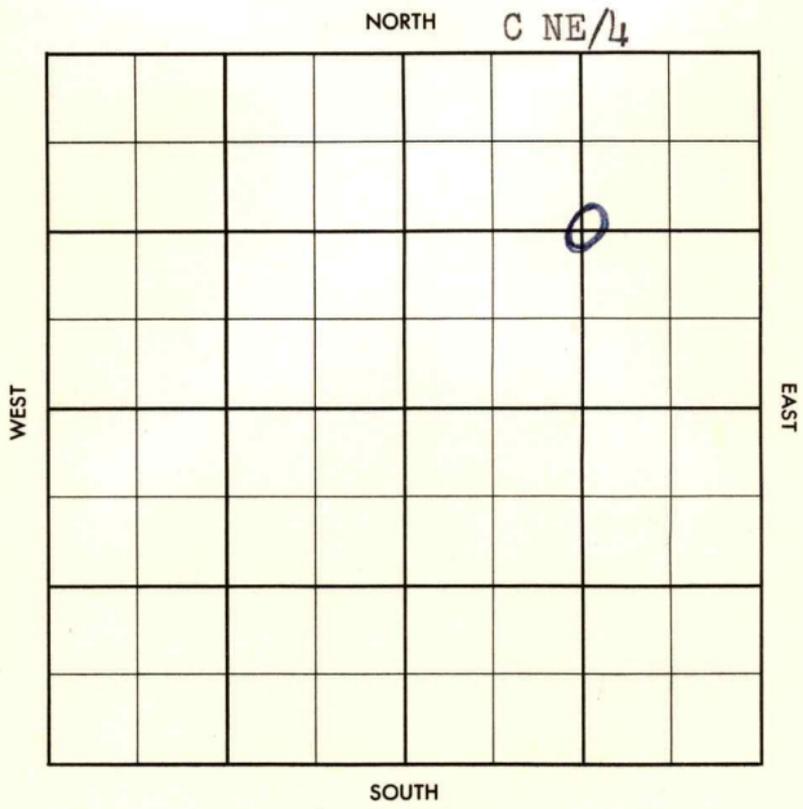

County Finney Elev. 2837 GL
 Sec. 17 Twp. 26 Rge. 31W
 Company Kansas Nebr.
 Farm Name Brensing No. _____

TOPS	DEPTH	LOG	DATUM
Anb. <u>Hol</u>	<u>2578</u>		
Tr. <u>eer</u>	<u>2614</u>		
Dg. <u>U Kri</u>	<u>2634</u>		
BL. <u>L Kri</u>	<u>2659</u>		
L. _____			
K.C. _____			
B.K.C. _____			
Ce. _____			
C. _____			
M. _____			
M. _____			
K. _____			
Mz. _____			
Me. _____			
V. _____			
S. _____			
S. _____			
A. _____			
R. _____			
PE. _____			
G. _____			
T.D. <u>RTD</u>	<u>2705</u>		

Loc. in Sec. C NE/4
 Geol. _____
 Contr. _____
 Fees Tools _____
 Pool Hugoton
 FIRST REPORT
 JUN 26 1957

Date Comm. 6-18-57
8" @ 447/300, 5" @ 2694/200

35

Co.
 Use.
 No.
 Sec.
 T.
 R.

County Finney Elev. 2837 GL
 Sec. 17 Twp. 26 Rge. 31W
 Company Kansas Nebr.
 Farm Name Brensing No. 2

	TOPS	DEPTH	LOG	DATUM
Anh.	<u>Hol</u>	<u>2578</u>		
Tp.	<u>eer</u>	<u>2614</u>		
H.				
Tr.	<u>U Kri</u>	<u>2634</u>		
Dg.	<u>L Kri</u>	<u>2659</u>		
BL.				
L.				
K.C.				
B.K.C.				
Ce.				
C.				
M.				
M.				
K.				
Mz.				
Me.				
V.				
S.				
S.				
A.				
R.				
PE.				
G.				
T.D.	<u>RTD</u>	<u>2705</u>		

Loc. in Sec. C NE/4
 Geol. _____
 Contr. _____
 Fees Tools _____
 Pool _____
Hugoton



Date Comm. 6-18-57
8" @ 447/300, 5" @ 2694/200 JUL 9 '57 JUL 10 '57
JUL 17 '57 98/2640-52 16/2660-64
16/2671-75 Frac 8x4 gal. 237
MLFG pd.

Co.
 Lse.
 No.
 Sec.
 T.
 R.