


Section 19 Township 26 Range 31 W

Well No. # 1 P. H. Parr

Company Kansas-Nebraska Natural Gas

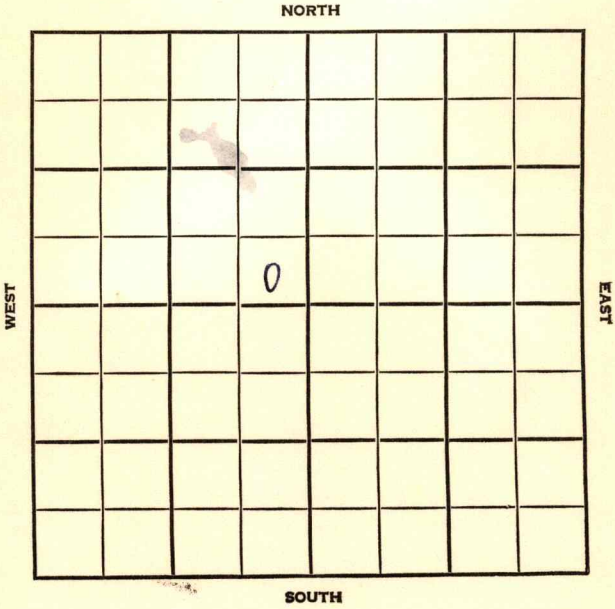

Finney KANSAS

SEC.	TWP.	R.
19	26	31W

WELL NO.

1 R. H. Parr

FARM

COMPANY

Kansas-Nebraska Natural Gas

CONTRACTOR


Hugoton Pool

Ft. from N. Line

330 Ft. from S. Line

330 Ft. from E. Line

Ft. from W. Line

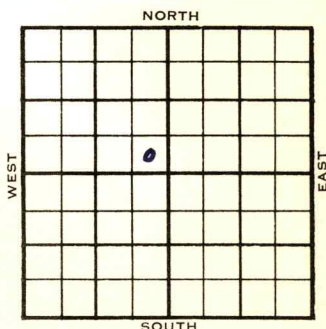

SE SE NW

Continental Farmout

	ELEVATION	REPORT
1954	2841'	
12/29	Spud 12-17-54 8" @ 569' Her. 2604', Kri. 2624', Tow. 2652', Win. 2682' TD 2708' 5" @ 2707'	
1955 2/2	Spud 12-17-54 - Gas Well TD 2708' 8" @ 569' Her. 2604', Kri 2624', Tow. 2652', Win. 2682' TD 2708' 5" @ 2707' CO 6/2696-2702, 1000A 250,000 cfg, 10 gawph PB 2672' 108/2626-44, 96/2650-66, 6000A 4,160,000 cfg, 2000A Comp. 10,647,000 cfghpd	

COMPLETED

County	Finney		State	Kansas	
Sec.	19	(Blk. Twp.)	26	(Sur. Rge.)	31W Map No.
Operator	Kansas-Nebraska Natural Gas				
Well No.	1	Farm	R. H. Parr		
Elev.	2841	Location	SE SE NW		

						330 Ft. From	S Line	NW
						330 Ft. From	E Line	Quarter
						1st. Report	DEC 29 1954	
						Completion		
						Remarks	Continental farmout	
						Spudding Date	12-17-54	

FIRST REPORT


Drlg. Data Hugoton Pool

8" @ 562 Her. 2604 Kri. 2624

Tow. 2652 Win. 2682 TD 2708 5" @ 2707

FABEN GILSTRAP

County Finney State Kansas
 Sec. 19 (Blk. 26 (Sur. 31W Map No.
 (Twp.) (Rge.)
 Operator Kansas-Nebraska Natural Gas
 Well No. 1 Farm R. H. Parr
 Elev. 2841 Location SE SE NW

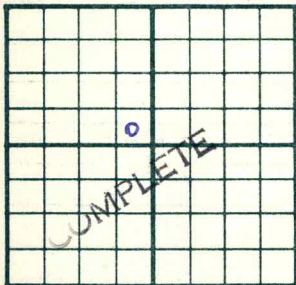

330 Ft. From S Line NW
330 Ft. From E Line Quarter
 1st. Report
 Completion FEB 2 1955
 Remarks Hugoton Pool
 Spudding Date 12-17-54

Drlg. Data Gas well TD 2708
8" @ 569 Her. 2604 Kri. 2624
Tow. 2652 Win. 2682 TD 2708 5" @ 2707
CO 6/ 2696-2702 1000 A 250,000 cfg
10 gawph PB 2672 108/ 2626-44
96/ 2650-66 6000 A 4,160,000 cfg
2000 A Comp. 10,647,000 cfgpd

FABEN GILSTRAP