


Section 20 Township 26 Range 31 W

Well No. # 1 Lightner

Company Micheelis Drlg.

NORTH

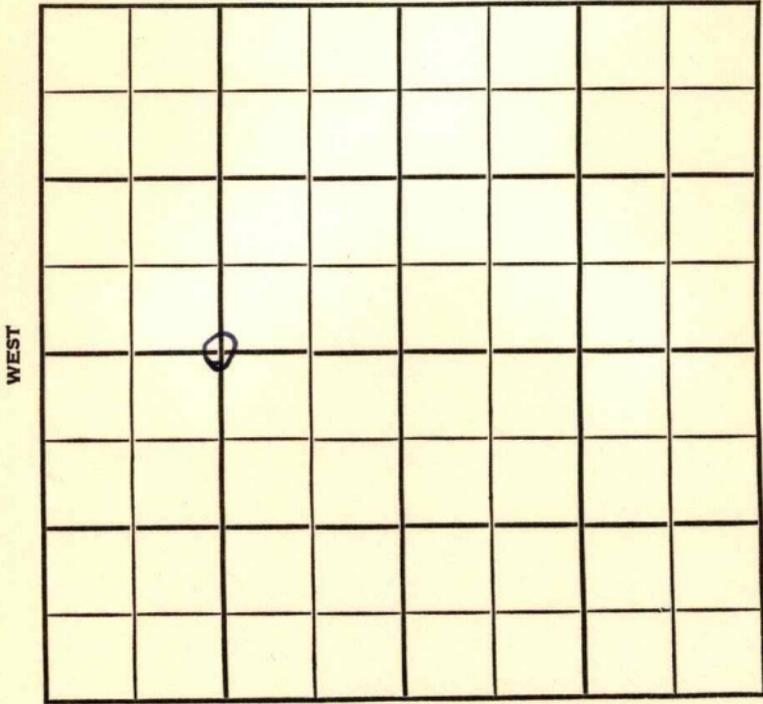

SOUTH

Finney

KANSAS

SEC. 20	TWP. 26	R. 31W
----------------	----------------	---------------

WELL NO. #1 Lightner FARM

COMPANY Michaelis Drlg.

CONTRACTOR Co. Tools.

Hugoton Pool


2640 _____ Ft. from N. Line

_____ Ft. from S. Line

_____ Ft. from E. Line

1320 _____ Ft. from W. Line

C W $\frac{1}{2}$ Sec CONTINENTAL F/O

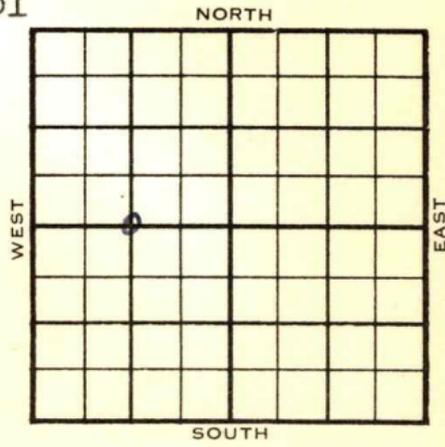

	ELEVATION	REPORT
1955	2840'	

3/16	8" @ 534' Kri. 2664', Her. 2642' Drlg. 2688'
4/20	Gas Well - TD 2710' 8" @ 534' Kri 2664', Her. 2642', TD 2710' 5" @ 2707' CO to 2690' 64/2670-86, 40/ 2658-68, frac dolo-flush frac dolo-flush Comp. 3,594,000 cfpd

COMPLETED

County **Finney** State **Kansas**

Sec. **20** (Blk. Twp.) **26** (Sur. Rge.) **31W** Map No.

Operator **Michaelis Drlg.**

Well No. **1** Farm **Lightner**

Elev. Location **C W $\frac{1}{2}$ Sec.**

2640 Ft. From **N** Line **Sec.**

1320 Ft. From **W** Line **Quarter**

Ist. Report **MAR 16 1955**

Completion

Remarks **Continental farmcut
Co. tools**

Spudding Date

Drlg. Data **Hugoton Pool**

8" @ 534 Kri. 2664 Her. 2642

drlg. 2688

County Finney State Kansas

Sec. 20 (Blk. 26) (Sur. 31W) (Twp. 26) (Rge. 31W) Map No.

Operator Michaelis Drlg.

Well No. 1 Farm Lightner

Elev. 2840 Location C W $\frac{1}{2}$ Sec.

2640 Ft. From N Line Sec.

1320 Ft. From W Line Quarter

1st. Report

Completion APR 20 1955

Remarks Hugoton Pool

Co. tools

Spudding Date

Drlg. Data Gas well TD 2710

8" @ 534 Kri. 2664 Her. 2642

TD 2710 5" @ 2707 CO to 2690

64/ 2670-86 40/ 2658-68 frac

dolo-flush frac dolo-flush

Comp. 3,594,000 cf/gpd