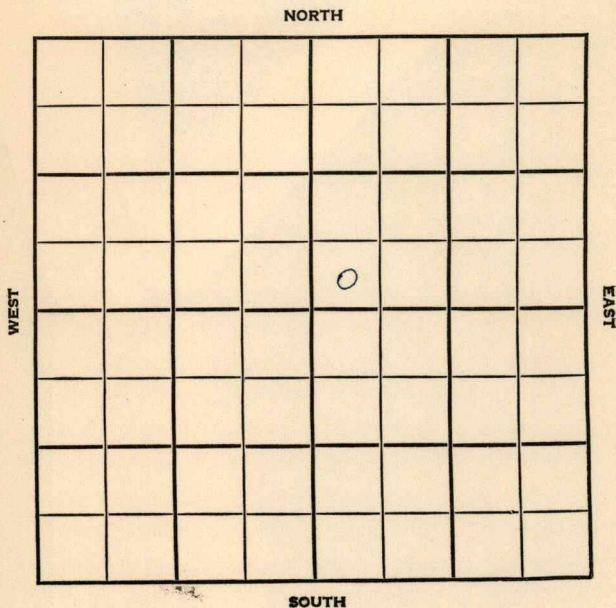


Section 31 Township 26 Range 37WWell No. #1 Hutton "A"Company Northern Natural

Kearny

KANSAS

SEC.

31

TWP.

26

R.

37W

WELL NO.

#1 Hutton "A"

FARM

COMPANY

Northern Natural

CONTRACTOR

G-M


____ FT. FROM N. LINE

____ FT. FROM S. LINE

____ FT. FROM E. LINE

____ FT. FROM W. LINE

SW SW NE

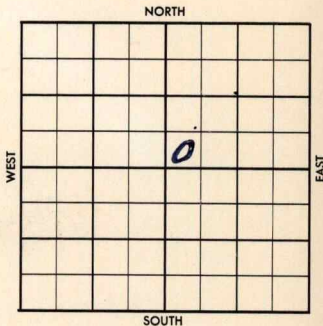

1956

ELEVATION

REPORT

8-1

Location

County Deer Elev. 3088
 Sec. 31 Twp. 26 Rge. 37W
 Company Northern Natural
 Farm Name Hutton "A" No. 1

TOPS	DEPTH	LOG	DATUM	Loc. in Sec.
Anb. <u>Herr</u>		<u>2348</u>		<u>SW SW NE</u>
Tp. <u>D. Kri</u>		<u>2372</u>		
H. <u>L. Kri</u>		<u>2394</u>		
Tr. <u>Wfd</u>		<u>2428</u>		
Dg. <u>gag</u>		<u>2450</u>		
Bl. <u>U. FTR</u>		<u>2482</u>		
L. <u>L. FTR</u>		<u>2540</u>		Geol. _____
K.C.				Contr. <u>G-M</u>
B.K.C.				
Ce.				Pool _____
C.				
M.				
M.				
K.				
Mz.				
Me.				
V.				
S.				
S.				
A.				
R.				
Pe.				
G.				
T.D.	<u>26.39</u>			OCT 17 '56 0 COMPLETE

Date Comm.

Location AUG 8 '56 7-31-56 #100
AUG 15 '56 P 5/8 231/150 WOR
AUG 22 '56 AUG 29 '56 SEP 5 '56 SEP 12 '56 SEP 19 '56
SEP 26 '56 5 1/2 @ 26.26/625 CO 28/
2380-93 48/2400-12 28/2434
-41 36/2454-63 56/2502-16
20/2522-27 108/2542-69 44/
2587-98 Frac ga 1.665 MCF
OCT 3 '56 OCT 10 '56 84-20⁹⁹ 2.260 MCFW RP
416 OCT 17 '56 complete

County Kearny Elev. _____Sec. 31 Twp. 26 Rge. 37WCompany Northern NaturalFarm Name Hutton "A" No. 1

TOPS

DEPTH

LOG

DATUM

Loc. in Sec. _____

Anh.

Tp.

H.

Tr.

Dg.

Bl.

L.

K.C.

B.K.C.

Ce.

C.

M.

M.

K.

Mz.

Mq.

V.

S.

S.

A.

R.

Pe.

G.

T.D.

Geol. _____

Contr. _____

G-M

Pool _____

FIRST REPORT			
		0	

Date Comm. _____

AUG 1 1956

Location _____

AUG 7 1956

R.C.