


Section 31 Township 26 Range 39W

Well No. 1 Heltemes "A"

Company Stanolind

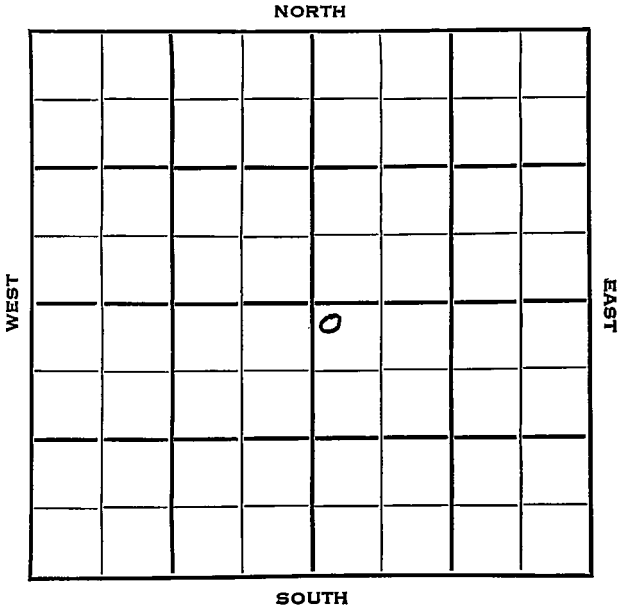

Hamilton KANSAS

SEC. 31	TWP. 26	R. 39 W
-------------------	-------------------	-------------------

WELL NO. _____

COMPANY **# 1 Heltemes "A"** FARM

CONTRACTOR **Stanolind**


Hugoton Pool

150 _____ Ft. from N. Line

_____ Ft. from S. Line

_____ Ft. from E. Line

150 _____ Ft. from W. Line

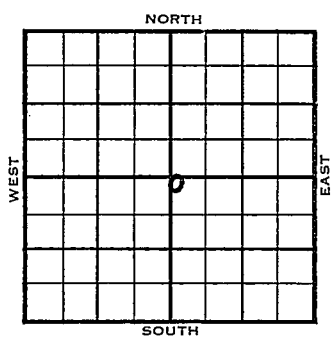

NW NW SE

1953	ELEVATION 3319'	REPORT
-------------	---------------------------	--------

11/4 Spud 10-27-53
 Her. 2406' Win. 2463' Tow. 2535'
 Ft. Riley 2585' TD 2609'
 8" @ 646 5" @ 2584'

11/11 CO Test.

11/18 Spud 10-27-53 Gas well TD 2609
 Her. 2406 Win. 2463 Tow. 2535
 Ft. Riley 2585 TD 2609 8" @ 646
 5" @ 2584 CO to 2609 frac.
 4/2406-08 108/2412-30 60/2434-44
 102/2463-80 24/2482-86 72/2490-2502
 48/2520-28 24/2535-39 30/2541-46
 90/2549-64 frac. 2535-64 2482-86
 Comp. 9,601,000 gas 410#

COMPLETED

