


KANSAS

Kearny

Section 31 Township 26 Range 36WWell No. 1 Summer sCompany Northern Natural Gas

Hugoton

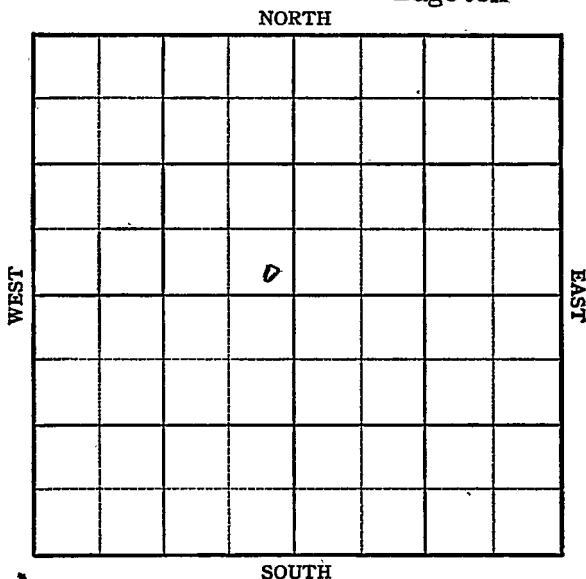

Kearny

KANSAS 36W

Sec. 31 Twp. 26 R.

Well No. #1 Sumners Farm

Northern Natural Gas Company
Hugoton Pool

Ft. from N. Line


200'

Ft. from S. Line

200'

Ft. from E. Line

Ft. from W. Line

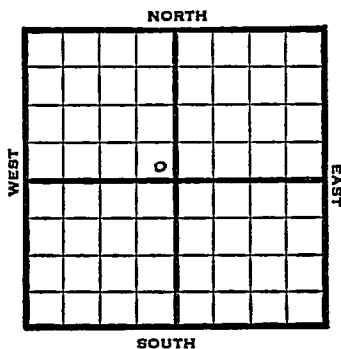

SE NW

1949

Elev 3104'

REPORT

9/7 Drlg. 480'
9/14 10" @ 437'
TD 2547
7" @ 2542'
9/21 "
9/28 TD 2730'
4000 acid
297' of 5" Liner @ 2730'
10/5 17000 acid
10/12 TD 2730'
7" @ 2543'
297' of 5" Perf Liner @ 2730'
21000 acid
16,001,000 Gas
405# R Pr.
Comp

COMPLETED

Map No. _____ Sec. 31 Twp. 26 R. 36W

Well No. 1 Sumners

Northern Natural Gas Company

Contractor

SE NW

**FIRST REPORT
SECTION PLAT**

_____ Ft. from N. Line

200 Ft. from S. Line

200 Ft. from E. Line

_____ Ft. from W. Line

Kearny County

RECORD

Location _____

Rig up _____

Drilling and Remarks:

drllg. 480

Cased _____ in., _____ ft.

Sand _____

Gas _____

Oil _____

Total Depth _____

PRODUCTION

1st 24 hrs. Nat. _____

1st 24 hrs. after shot _____

Gas _____ Cu. Ft.

Dry Hole _____

Abandoned _____

Date

SEP 7 1949

19

S. J. LEWIS Scout

Map No. _____ Sec. 31 Twp. 26 R. 36W

Well No. 1 Sommers

Northern Natural Gas Company

COMPLETE

Contractor

SE NW


E13104
SECTION PLAT

_____ Ft. from N. Line

200 Ft. from S. Line

200 Ft. from E. Line

_____ Ft. from W. Line

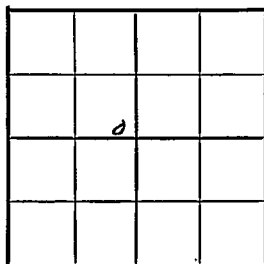

Kearny County

RECORD

Location _____

Cased _____ in., _____ ft.

Rig up _____

Sand _____

Drilling and Remarks:

Gas _____

Oil _____

Total Depth 2730.

2" @ 2543

297' x 5' Per line

@ 2730.

21000 acid

16,001,000 lbs.

40.5" P 1/2

PRODUCTION

1st 24 hrs. Nat. _____

1st 24 hrs. after shot _____

Gas _____ Cu. Ft.

Dry Hole _____

Abandoned _____

Date

OCT 12 1949

19

S. J. LEWIS

Scout