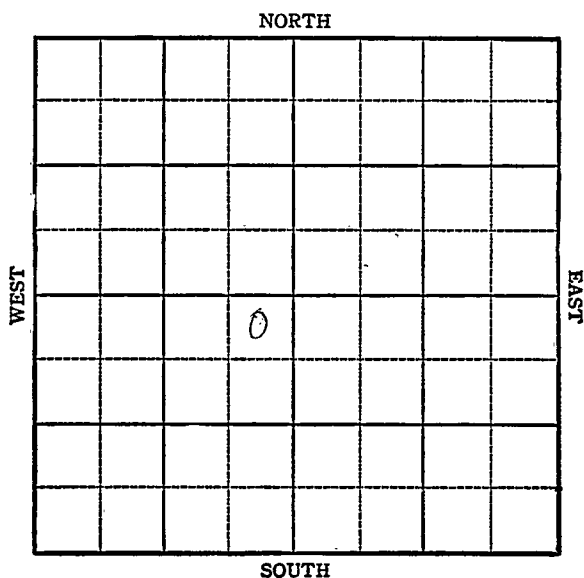


KANSASFinnySection 31 Township 26 Range 34WWell No. #1 CurryCompany Helmerick & Payne

KANSAS

Sec. 31 Twp. 26 R. 34W

Well No. #1 Curry Farm
Helmerick & Payne Company


Hugoton

100 Ft. from N. Line

 Ft. from S. Line

100 Ft. from E. Line

 Ft. from W. Line

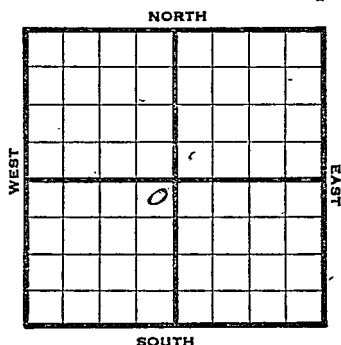

Finney NE SW

1944 ELEV. 3039 R E P O R T

11/29	470
12/6	Drlg. 1000 10" @ 760
12/14	Drlg. 2200'
12/21	Drlg. 2365
12/29	5" @ 2725' TD 2738 RUST
<u>1945</u> <u>1/3</u>	" " "
1/10	" " "
1/17	" " " "
1/26	" " "
1/31	TD 2746 3500 acid ESt. 2½ M Gas
2/7	Rip csg 2640-42 2676-82; 2716-25 9000 acid
2/14	" " " "
2/21	" " " "
2/28	" " " "
3/7	" " " "
3/14	" " " "
3/23	" " " "
3/29	" " " "
4/5	" " " "

OVER

1945

4/11 5" @ 2725
Rip Csg. -
TD 2746
23000 acid.
7,713,000 Gas
426# R PR.

COMPLETED

Pool Name HugotonMap No. N/M Sec. 31 Twp. 26 R. 34WWell No. 1 CurryHelmerick & Payne CompanyFIRST REPORT

Contractor

NE SW

SECTION PLAT

100 Ft. from N. Line Ft. from S. Line100 Ft. from E. Line Ft. from W. Line

	P		

FirneyLocation Rig up

Drilling and Remarks:

470

RECORD

Cased in., ft.Sand Gas Oil Total Depth

PRODUCTION

1st 24 hrs. Nat. 1st 24 hrs. after shot Gas Cu. Ft.Dry Hole Abandoned

Date

NOV 29 194419S. J. LEWIS

Scout

no wall map


Misc Small Maps	<i>HC</i>
Cards	<i>DTA</i>
Tracing	
France Map	
Scarborough Map	<i>LC</i>
Moody Map	
Geological Dept.	
City of Brock	

Kansas

Pool Name HugotonMap No. No map Sec. 31 Twp. 26 R. 34WWell No. 1 CurryHelmerick & Payne Company**COMPLETED**

Contractor

NE SW

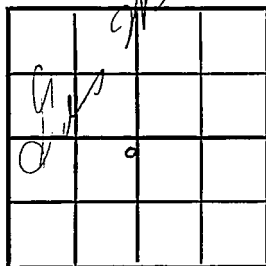SECTION PLAT100 Ft. from N. Line Ft. from S. Line100 Ft. from E. Line Ft. from W. Line

Finney

Location Rig up

Drilling and Remarks:

5-52725Rip C 17.23000 acid7, 713,000426 R Pl**RECORD**Cased in., ft.Sand Gas Oil Total Depth 2746**PRODUCTION**1st 24 hrs. Nat. 1st 24 hrs. after shot Gas Cu. Ft.Dry Hole Abandoned

Date

APR 11 194519S. J. LEWIS Scout

Misc. Small Maps_____

Cards_____ *Settly*

Tracing_____

France Map_____ ~~X~~

Scarborough Map_____ ~~X~~

Moody Map_____

Geological Dept._____

Moody Plat Book_____