

KANSAS KearnySection 31 Township 26 Range 35WWell No. 1 DoaseCompany MagnoliaHugoton
NORTH

				0			

SOUTH

KANSAS

Kearny

Sec. 31 Twp. 26 R. 35W ✓

Well No. #1 Doase Farm

Magnolia

Company

Hugoton Pool


330' Ft. from N. Line

Ft. from S. Line

Ft. from E. Line

330' Ft. from W. Line

NW SE

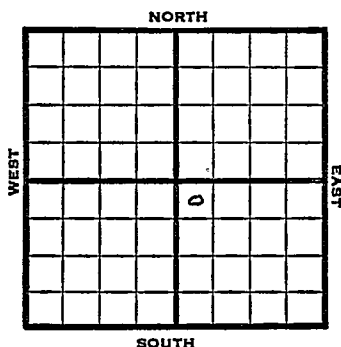

1949 Elev 3070' REPORT

4/6 Location
4/12 8" @ 826'
4/20 Drlg. 2660'
4/27 TD 2785'
7" @ 2784'
5/4 240 shots 2666-2731
Acid 14,000
5/10 240 shots 2548-2626 - 14,000 acid
5/18 "
5/25 TD 2785'
5" @ 2784'
Perf 28000 acid
15,900,000 Gas
389# R Pr.
Comp

COMPLETED

Kansas

Map No. _____ Sec. 31 Twp. 26 R. 35WWell No. 1 Doase_____ Magnolia _____ Company_____ FIRST REPORT _____ Contractor

NW SE

SECTION PLAT

330

_____ Ft. from N. Line

_____ Ft. from S. Line

_____ Ft. from E. Line

330

_____ Ft. from W. Line

		o	

Kearny County

Location X

Rig up _____

Drilling and Remarks:

RECORD

Cased _____ in., _____ ft.

Sand _____

Gas _____

Oil _____

Total Depth _____

PRODUCTION

1st 24 hrs. Nat. _____

1st 24 hrs. after shot _____

Gas _____ Cu. Ft.

Dry Hole _____

Abandoned _____

Date

APR 6 1949 19 S. J. LEWIS Scout

Map No. _____ Sec. 31 Twp. 26 R. 35W

Well No. 1 Doase

Magnolia Company

COMPLETE

Contractor

NW SE

E 13070


SECTION PLAT

330 Ft. from N. Line

_____ Ft. from S. Line

_____ Ft. from E. Line

330 Ft. from W. Line

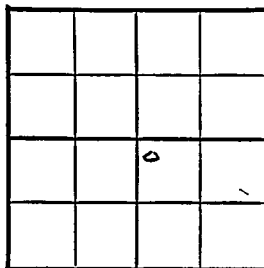

Kearny County

Location _____

Rig up _____

Drilling and Remarks:

5' 11' 02784

Perf.

28000 actual

15,900,000 cu

389 R/R

RECORD

Cased _____ in., _____ ft.

Sand _____

Gas _____

Oil _____

Total Depth 2785

PRODUCTION

1st 24 hrs. Nat. _____

1st 24 hrs. after shot: _____

Gas _____ Cu. Ft.

Dry Hole _____

Abandoned _____

Date

MAY 25 1949

S. J. LEWIS

Scout