

KANSAS

Finney


Section 31 Township 26 Range 33W

Well No. 1 Adams

Company Magnolia

Hugoton

NORTH

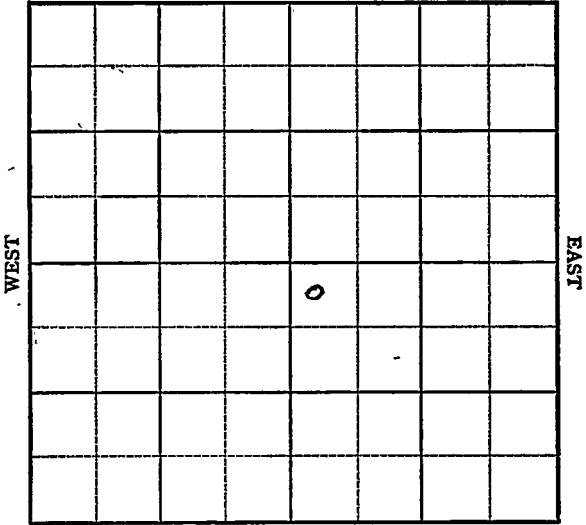

SOUTH

Finney

KANSAS

33W

Sec. 31

Twp.

26

R.

Well No. #1 Adams

Farm

Magnolia

Company

Hugotm Pool (Barnett Drlg, Cont.)


330' Ft. from N. Line

Ft. from S. Line

Ft. from E. Line

330' Ft. from W. Line

NW SE

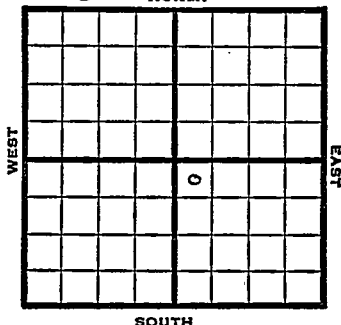

1949 Elev. 2948' REPORT

9/7 10" @ 846'
TD 2835'
7" @ 2834'

9/14 "

9/21 "

9/28 408 shots 2598-2744'
28000 acid

10/5 48 shots 2579-87
7000 acid

10/12 "

10/19 "

10/26 7" @ 2834'
Perf
Acid 35,000
Gas 18,600,000
R Pr. 408#
TD 2835'

COMPLETED

Map No. _____ Sec. 31 Twp. 26 R. 33W

Well No. 1 Adams

Magnolia Company

Barnett Drlg. Contractor

**FIRST REPORT
SECTION PLAT**


NW SE

330 Ft. from N. Line

_____ Ft. from S. Line

_____ Ft. from E. Line

330 Ft. from W. Line

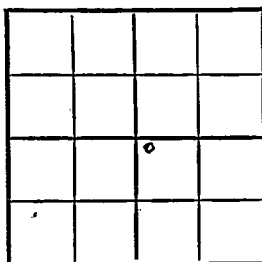

Finney County

RECORD

Location _____

Rig up _____

Drilling and Remarks:

10" @ 846

TD 2835

7" @ 2834

Cased _____ in., _____ ft.

Sand _____

Gas _____

Oil _____

Total Depth _____

PRODUCTION

1st 24 hrs. Nat. _____

1st 24 hrs. after shot _____

Gas _____ Cu. Ft.

Dry Hole _____

Abandoned _____

Date

SEP 7 1949

19

S. J. LEWIS Scout


Kansas

Hugoton Pool

Map No. _____ Sec. 31 Twp. 26 R. 33WWell No. 1 Adams_____Magnolia_____
Company**COMPLETE**

Contractor

NW SE

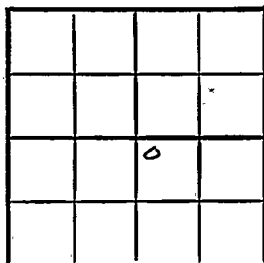E 1, 2948
SECTION PLAT330 Ft. from N. Line

_____ Ft. from S. Line

_____ Ft. from E. Line

330 Ft. from W. LineFinney County

Location _____

Rig up _____

Drilling and Remarks:

7 "C2834Perf. 18,600,000 gal408# R/P**RECORD**

Cased _____ in., _____ ft.

Sand _____

Gas _____

Oil _____

Total Depth 2835**PRODUCTION**

1st 24 hrs. Nat. _____

1st 24 hrs. after shot _____

Gas _____ Cu. Ft.

Dry Hole _____

Abandoned _____

Date

OCT 26 1949 19S. I. LEWIS Scout