


Section 1 Township 26 Range 32W

Well No. #1 J. Lightner

Company Kansas-Nebraska

KANSAS 32W

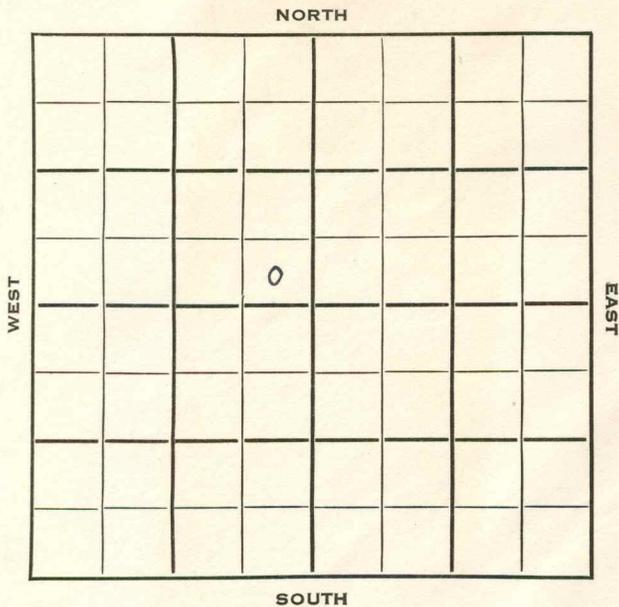

SEC.	TWP.	R.
1	26	32W ✓
WELL NO.		
1 J. Lightner		
COMPANY		
Kansas-Nebraska		
CONTRACTOR		

FARM


Hugoton Pool

\_\_\_\_\_ Ft. from N. Line

360 \_\_\_\_\_ Ft. from S. Line

250 \_\_\_\_\_ Ft. from E. Line

\_\_\_\_\_ Ft. from W. Line

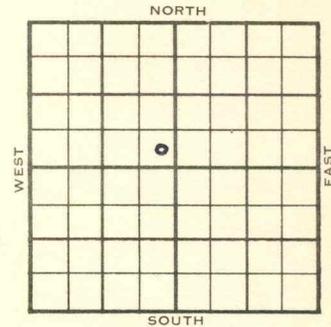

SE SE NW

1954	ELEVATION <u>2845'</u>	REPORT
------	---------------------------	--------

2/24 MIR

3/3 Pipe Stuck @ 2680'

3/17 RTD 2690'  
5" @ 2683'  
TD 2700'

4/7 Spud 2-24-54 Gas well TD 2700  
TD 2690 5" @ 2683 DD 2700 1000 A  
200 GWPB PB 2663 240/2618-58  
frac. Her. 2618 Kri. 2642  
Win. 2673  
Comp. 1½ MCFGPD

COMPLETED

