


KANSAS

Section 9 Township 26 Range 32W

Well No. #1 John Miller Gas Unit

Company Stanolind

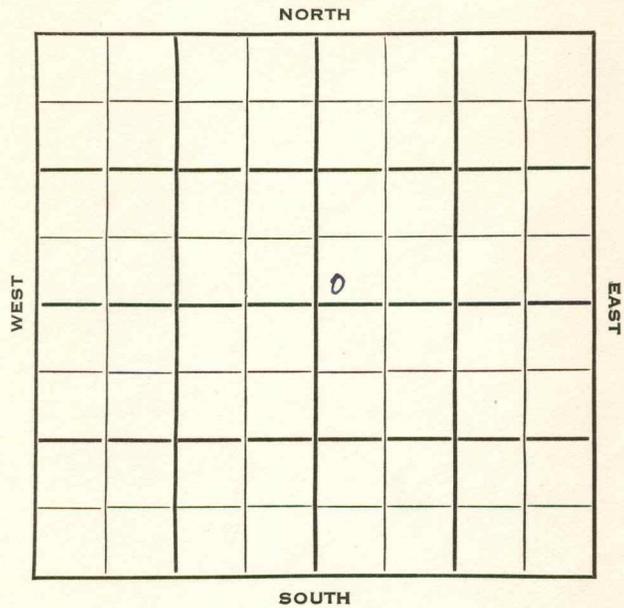


WELL NO. 9 26 32W

#1 John Miller Gas Unit FARM

COMPANY Stanolind

CONTRACTOR

Hugoton Pool

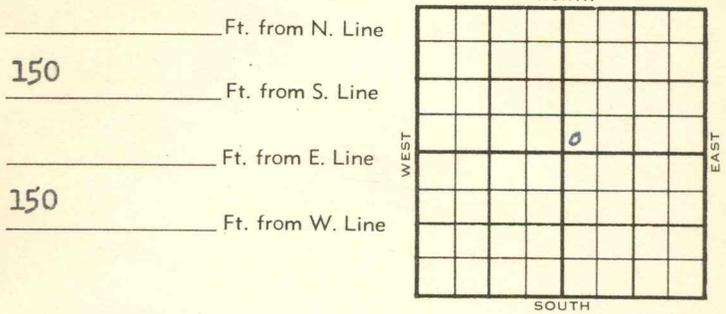

SW SW NE

	ELEVATION	REPORT
1954	2860'	
2/17		Location
3/3		8" @ 886' w/500 sks RTD 2690' Schl 5" @ 2663' Her. Kr. 2604', Win 2663'
3/10		CO 2690' 2500 A 60/ 2609-19 18/ 2622-25 12/ 2631-33 18/ 2635-38 2000 A
3/24		Spud 2-23-54 Gas Well TD 2690' 8" @ 886' Her. Kri. 2604', Win 2663', TD 2690' 5" @ 2663' CO to 2690' 2500 A 60/ 2609-19 18/ 2622-25 12/ 2631-33 18/ 2635-38 2000 A 7000 A 1,060,000 gas 10,000 A 1,261,000 gas 5 gswph 2000 A Comp 3,303,000 gas 345#

COMPLETED

