


Section 7 Township 26 Range 32W

Well No. #1 Barger

Company W.E. Bakke

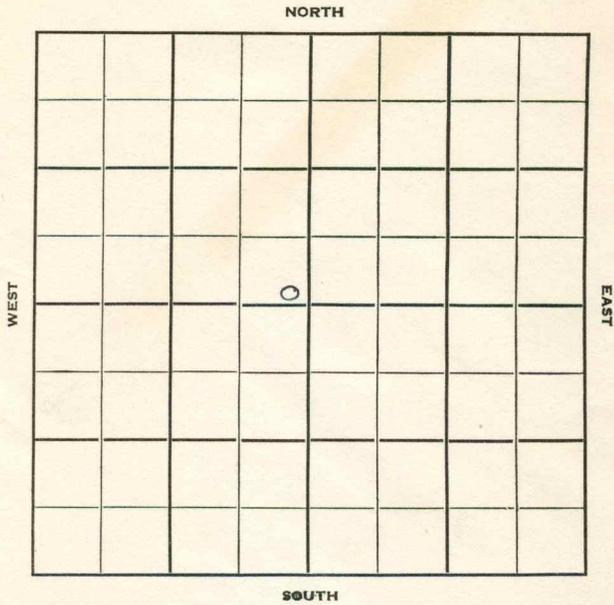

Sec. 7 Twp. 26 R. 32W

Well No. #1 Barger Farm

W.E. Bakke Company

Contractor


..... Ft. from N. Line

100 Ft. from S. Line

100 Ft. from E. Line

..... Ft. from W. Line

SE SE NW

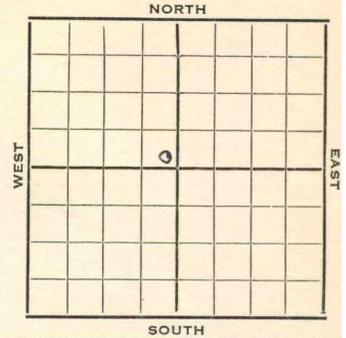

1952 **elev. 2877'** REPORT

- 8/20 Drlg. 1900'
- 8/27 **Her. 2564** RTD 2570
7" @ 2565'
- 9/3 Drlg. 2605'
- 9/10 **Winfield 2641** Up Ft 2680
1500 A DD 2654 2500 A
DD 2702 TD PB 2690 18,500 A
131' of 4" liner
- 9/17 Spud 8-14-52
Gas well TD 2702' 8" @ 494
Her 2564' 7" @ 2565' TD 2570'
Win 2641' **Ft. Riley 2680'** 1500 A
DD 2654' 2500 A DD 2702'
PB 2690 18,500 A
Comp. 7,066,000 gas

COMPLETED

