


KANSAS

Finney
 Section 10 Township 26 Range 32W
 Well No. #1 Lightner
 Company Nate Appleman

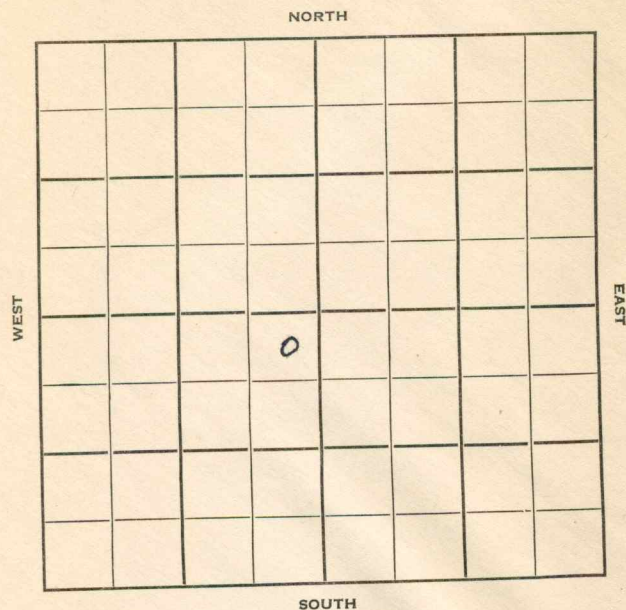


Finney

Sec. 10 Twp. 26 R. 32W
 Well No. #1 Lightner Farm
Nate Appleman Company
 Contractor

100 Ft. from N. Line
 _____ Ft. from S. Line
100 Ft. from E. Line
 _____ Ft. from W. Line

NE SW

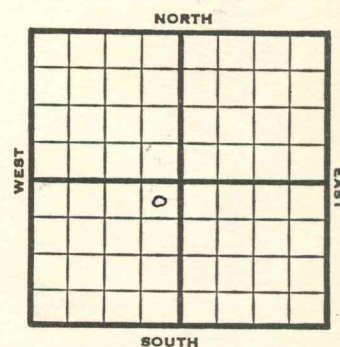

1953

Elev. 2853' REPORT

3/18	Location
3/26	"
4/2	"
4/9	8" @ 544'
	Her. 2609', Kr 2630, Win 2666
	TD 2700'
	5" @ 2663'
4/16	C.O.
4/23	NR
4/30	Testing
5/6	Spud 3-24-53
	Gas Well
	TD 2700'
	8" @ 544'
	Her. 2609', Kri 2630, Win 2666,
	TD 2700'
	5" @ 2663'
	CO to 2700
	1000 A PB 2652 90/ 2610-26 90/
	2631-48 1000 A
	Comp. 3,663,000 gas

COMPLETED

County	Finney	State	Kansas
Sec.	10	(Bk. Twp.)	26 (Sur. Rge.) 32W Map No.
Operator	Nate Appleman		
Well No.	1	Farm	Lightner
Elev.	2853	Location	NE SW

COMPLETE									
o									

100 Ft. From	N	Line	SW
100 Ft. From	E	Line	Quarter
1st. Report			
Completion MAY 6 1953			
Remarks			
Spudding Date		3-24-53	

Drig. Data	Gas well	TD 2700
8" @ 544	Her. 2609	Kri. 2630
Win. 2666	TD 2700	5" @ 2663
CO to 2700	1000 A	PB 2652 90/ 2610-26
90/ 2631-48	1000 A	
Comp. 3,663,000 gas		

J. G. MCGEEHIE

[illegible]

J. G. McGEHEE