


Finney

KANSAS

Section 14 Township 26 Range 32W
 Well No. #1 Ohmes
 Company Nate Appleman

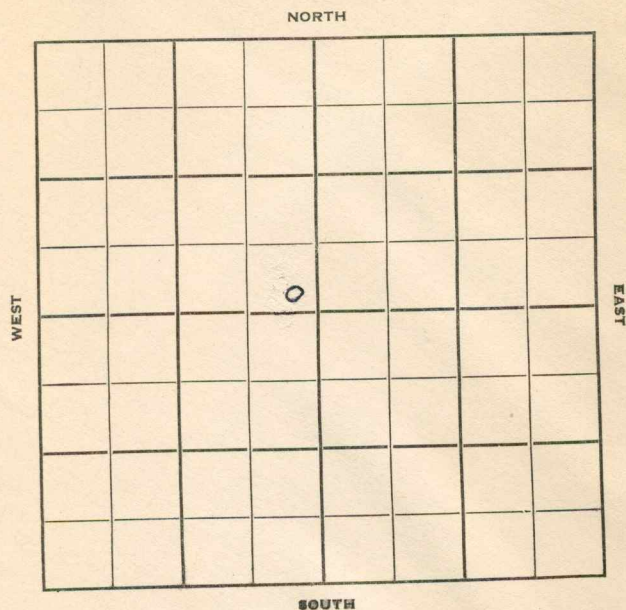


Finney

KANSAS

Sec. 14 Twp. 26 R. 32W
 Well No. #1 Ohmes Farm
 Nate Appleman Company

Hugoton Pool
 Ft. from N. Line
150'
 Ft. from S. Line
150'
 Ft. from E. Line
 Ft. from W. Line
 SE NW

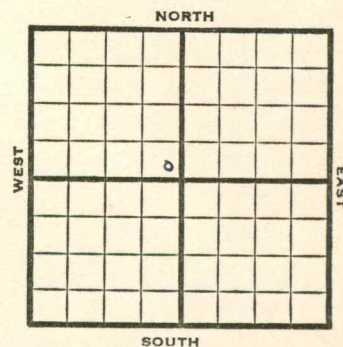

1951 **Elev. 2901'** REPORT

10/24 Location
 12/12 Spud 10-27-51
 Gas Well TD 2757
 8" @ 536
Her. 2672 Kri. 2694 Win. 2725
 TD 2731 5" @ 2727 DD 2757
 5000 A 180/ 2672-90 114/2694-2714
 4000 A CO to 2757 4000 A
 11000 total acid Comp. 10,439,000 gas

COMPLETED

County Finney State Kansas
 Sec. 14 (Blk. Twp.) 26 (Sur. Rge.) 32W Map No.
 Operator Nate Appleman
 Well No. 1 Farm Ohmes
 Elev. 2901 Location SE NW

						150 Ft. From	S Line	NW
						150 Ft. From	E Line	Quarter
						Ist. Report	<u>DEC 1 2 1951</u>	
						Completion	<u>Hugoton Pool</u>	
						Remarks		
						Spudding Date	<u>10-27-51</u>	

COMPLETE

Drlg. Data Gas well TD 2757
8" @ 536 Her. 2672 Kri. 2694
Win. 2725 TD 2731 5" @ 2727 DD 2757
5000 A 180/ 2672-90 114/ 2694-2714
4000 A CO to 2757 4000 A
11000 total acid Comp. 10,439,000 gas

J. E. TYRA

County Finney State Kansas
 Sec. 14 (Blk. Twp.) 26 (Sur. Rge.) 32W Map No.
 Operator Nate Appleman
 Well No. 1 Farm Ohmes
 Elev. Location SE NW

						150 Ft. From	S Line	NW
						150 Ft. From	E Line	Quarter
						Ist. Report	<u>OCT 24 1951</u>	
						Completion		
						Remarks		
						Spudding Date		

FIRST REPORT

Drlg. Data Hugoton Pool
Location

J. E. TYRA