


Section 20 Township 26 Range 32W
 Well No. #1 Yardley
 Company Cities Service

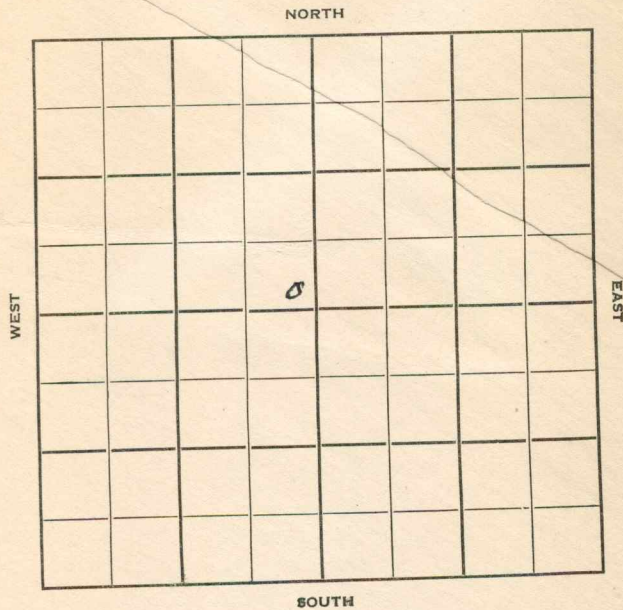


Sec. 20 Twp. 26 R. 32W
 Well No. #1 Yardley Farm
 Cities Service Company
 Contractor

Hugoton Pool

Ft. from N. Line
100' Ft. from S. Line
100' Ft. from E. Line
 Ft. from W. Line

SE NW

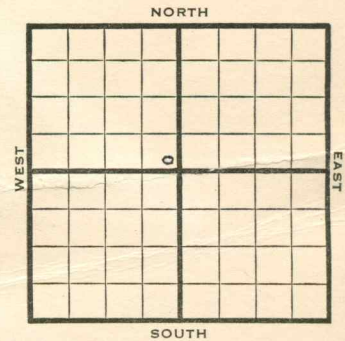

1950

Elev 2902'

REPORT

2/8

Location

3/29

TD 2735'

8" @ 760'

5" @ 2734'

Herv 2602'

U Kr 2612'

Win 2880'

8,730,000 CFGPD

Comp

COMPLETED

Kansas

Map No. _____ Sec. 20 Twp. 26 R. 32W

Well No. 1 Yardley

Cities Service Company

Contractor

SE NW

E. 2902
SECTION PLAT

Ft. from N. Line

100

Ft. from S. Line

100

Ft. from E. Line

Ft. from W. Line

COMPLETE			

Finney County

Location _____

Rig up _____

Drilling and Remarks:

8" @ 760
5' @ 2734
Hw 2602
Vkr 2612
Win 2880
8,730,000

CFGPD

Date

MAR 29 1950

19

J. E. TYRA

Scout

RECORD

Cased _____ in., _____ ft.

Sand _____

Gas _____

Oil _____

Total Depth 2735

PRODUCTION

1st 24 hrs. Nat. _____

1st 24 hrs. after shot _____

Gas _____ Cu. Ft.

Dry Hole _____

Abandoned _____

Kansas

Map No. _____ Sec. 20 Twp. 26 R. 32W

Well No. 1 Yardley

Cities Service Company

Contractor

SE NW

SECTION PLAT

Ft. from N. Line

100

Ft. from S. Line

100 Ft. from E. Line

Ft. from W. Line

Finney County

Location _____

Rig up _____

Drilling and Remarks:

8" @ 760
5' @ 2734
Hw 2602
Vkr 2612
Win 2880
8,730,000

CFGPD

Date

FEB 8 1950

19

J. E. TYRA

Scout

RECORD

Cased _____ in., _____ ft.

Sand _____

Gas _____

Oil _____

Total Depth _____

PRODUCTION

1st 24 hrs. Nat. _____

1st 24 hrs. after shot _____

Gas _____ Cu. Ft.

Dry Hole _____

Abandoned _____