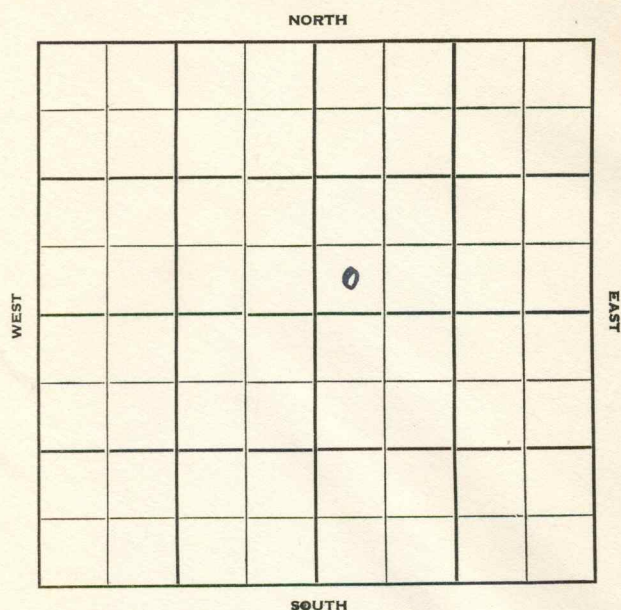


Section 22 Township 26 Range 32 WWell No. # 1 OhmesCompany Champlin Ref.Sec. 22 Twp. 26 R. 32 WWell No. # 1 Ohmes FarmChamplin Ref. Company

Contractor


Ft. from N. Line

330 Ft. from S. Line

Ft. from E. Line

330 Ft. from W. Line

SW SW NE

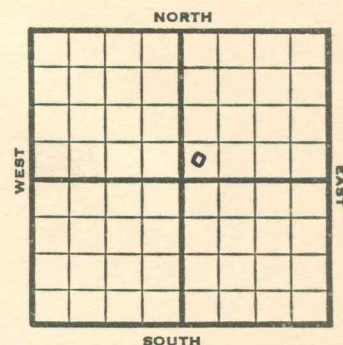

1953

Elev. 2881' REPORT

6/24

Location

7/1

"

7/8

10" @ 492
Drlg. 2350

7/22

N.R.

9/16

Spud 6-28-53
Gas Well

TD 2762'

10" @ 492'

Her. 2664, Kri 2684, Win 2718

TD 2762'

7" @ 2762'

CO to 2762 26/ 2718-24 84/ 2730-

44 3000 A PB 2710 CO to 2762

PB 2710 108/ 2687-2703 90/ 2664-79

4000 A CO to 2762 14,000 A

32/ 2700-08 PB 2700 CO to 2749

SP 2704

A-frac

Comp 7 1/3 mcf/gpd 385#.

COMPLETED

County	Finney		State	Kansas	
Sec.	22	(Blk. Twp.)	26	(Sur. Rge.)	3 2W Map No.
Operator	Champlin Ref.				
Well No.	1	Farm	Ohmes		
Elev.	2881	Location	SW SW NE		

0

COMPLETE

330 Ft. From S Line NE

330 Ft. From W Line Quarter

1st. Report

Completion SEP 16 1953

Remarks

Spudding Date 6-28-53

Drlg. Data Gas well TD 2762

10" @ 492 Her. 2664 Kri. 2684

Win. 2718 TD 2762 7" @ 2762

CO to 2762 26/ 2718-24 84/ 2730-44

3000 A PB 2710 CO to 2762 PB 2710

108/ 2687-2703 90/ 2664-79 4000 A

CO to 2762 14,000 A 32/ 2700-08

PB 2700 CO to 2749 SP 2704

A-frac Comp. 7 1/3 mcf/gpd 385#

J. G. McGEHEE

County	Pinney		State	Kansas	
Sec.	22	(Blk. Twp.)	26	(Sur. Rge.)	32W Map No.
Operator	Champlin Ref.				
Well No.	1	Farm	Ohmes		
Elev.	Location SW SW NE				

FIRST REPORT

330 Ft. From S Line NE

330 Ft. From W Line Quarter

1st. Report JUN 24 1953

Completion

Remarks

Spudding Date

Drlg. Data

Location

J. G. McGEHEE