


Section 23 Township 26 Range 32W

Well No. #2 Ohmes

Company Nate Appleman

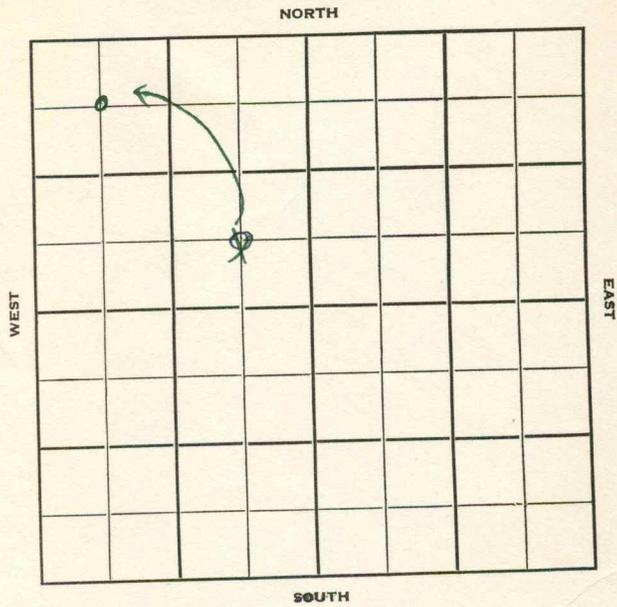

Sec. 23 Twp. 26 R. 32W

Well No. #2 Ohmes Farm

Nate Appleman Company

Contractor


660 Ft. from N. Line

660 Ft. from S. Line

500 Ft. from E. Line

550 Ft. from W. Line

App. C <sup>NW</sup> ~~SE~~ NW

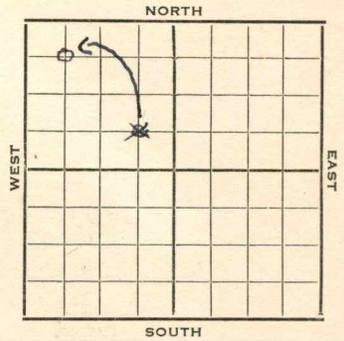

1952 Elev. 2886' REPORT

8/20	Location
8/27	"
9/3	"
9/10	"
9/17	"
9/24	8" @ 562
10/1	TD 2760'
	5" @ 2736'
10/8	"
10/15	"
10/22	N. R.
10/29	CO 2760 4000A 108/2678-96, 108/2700 2718
11/5	NR
11/12	"
11/20	"
11/27	"
12/3	Spud 9-17-52 Gas Well TD 2760' 8" @ 562 TD 2760 5" @ 2736 CO to 2760 4000A

**OVER**

(Information Brought Forward)

1952  
13/2

108/2678-96, 108/2700-18  
Her. 2678, Kri. 2700, Win  
2734  
Comp. 3,900,000 gas

**COMPLETED**

Kansas

Map No. \_\_\_\_\_ Sec. 23 Twp. 26 R. 32W

Well No. 2 Ohmes

Nate Appleman Company

**CORRECTION** Contractor

C NW NW

SECTION PLAT

660 Ft. from N. Line  
\_\_\_\_ Ft. from S. Line  
\_\_\_\_ Ft. from E. Line  
550 Ft. from W. Line

0			

Finney County

Location \_\_\_\_\_

Rig up \_\_\_\_\_

Drilling and Remarks:

Reported

C SE NW

RECORD

Cased \_\_\_\_\_ in., \_\_\_\_\_ ft.

Sand \_\_\_\_\_

Gas \_\_\_\_\_

Oil \_\_\_\_\_

Total Depth \_\_\_\_\_

PRODUCTION

1st 24 hrs. Nat. \_\_\_\_\_

1st 24 hrs. after shot \_\_\_\_\_

Gas \_\_\_\_\_ Cu. Ft.

Dry Hole \_\_\_\_\_

Abandoned \_\_\_\_\_

Date

SEP 10 1952


19

J. G. McGEHEE

Scout

County Finney State Kansas  
 Sec. 23 (Blk. 26 (Sur. 32W Map No. 26) (Twp. 32W)  
 Operator Nate Appleman  
 Well No. 2 Farm Ohmes

Elev. 2886 Location C SE NW

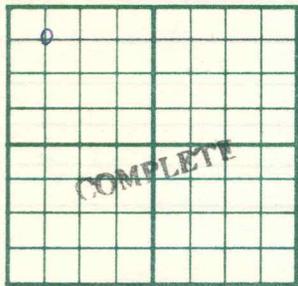

660 Ft. From N Line NW  
550 Ft. From W Line Quarter

Ist. Report  
 Completion DEC 3 1952  
 Remarks

Spudding Date 9-17-52

Drig. Data Gas well TD 2760  
8" @ 562 TD 2760 5" @ 2736  
CO to 2760 4000 A 108/ 2678-96  
108/ 2700-18 Her. 2678 Kri. 2700  
Win. 2734 Comp. 3,900,000 gas

J. G. McGEHEE

County Finney State Kansas  
 Sec. 23 (Blk. 26 (Sur. 32W Map No. 26) (Twp. 32W)  
 Operator Nate Appleman  
 Well No. 2 Farm Ohmes

Elev. Location App C SE NW



660 Ft. From S Line NW  
500 Ft. From E Line Quarter

Ist. Report AUG 20 1952  
 Completion  
 Remarks

Spudding Date

Drig. Data  
Location

J. G. McGEHEE