


Section 24 Township 26 Range 32W
 Well No. #1 Gigot
 Company Kansas-Nebraska

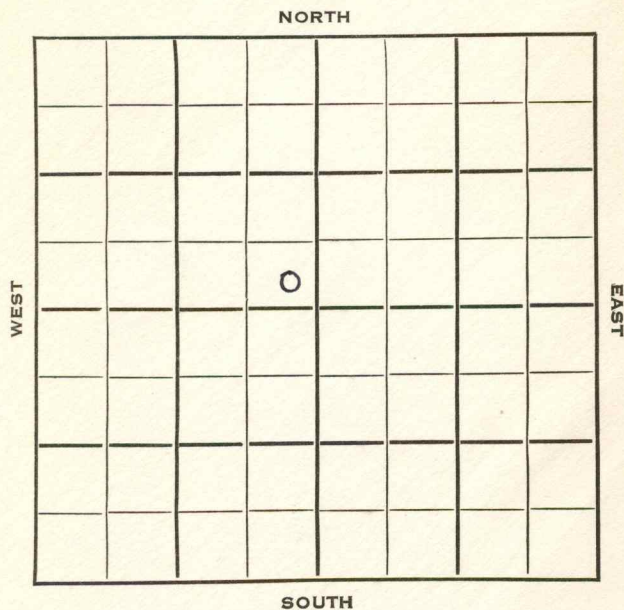

Sec. 24 Twp. 26 R. 32W

Well No. #1 Gigot Farm

Kansas-Nebraska Company


Hugoton Pool Contractor

200 Ft. from N. Line

200 Ft. from S. Line

200 Ft. from E. Line

SE NW Ft. from W. Line

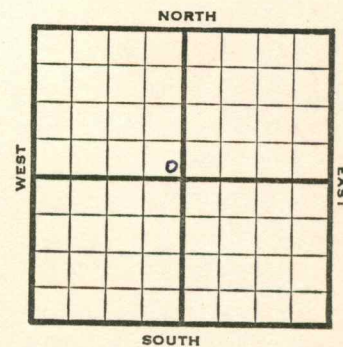

1953

Elev. 2860' REPORT

4/29

Location

5/7

10" @ 585
Drlg. 11400'

5/21

RTD 2730'
7" @ 2724'

5/28

NR

6/3

373/2638-2720 6000 frac plus 2000
gal Ker.

6/10

Her 2638' Kr 2662' Win 2694'

6/24

NR

7/1

"

7/22

Spud 4-26-53

Gas Well

TD 2730'

10" @ 585'

7" @ 2724'

TD 2730'

373/2638-2720 600 frac. Her 2638

Kri 2662, Win 2694

Comp. 452,000 gas 423#

COMPLETED

J. G. McACHEE

J. G. McGEHEE