


Section 32 Township 26 Range 39W

Well No. 1 Heltemes "B"

Company Stanolind

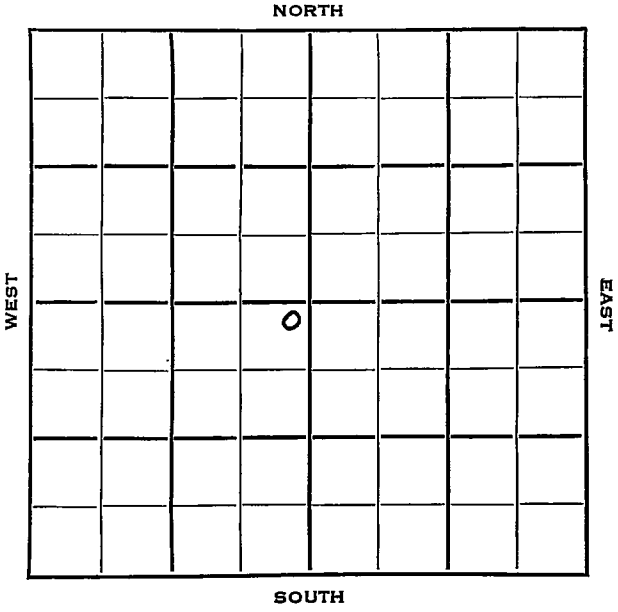

Hamilton

KANSAS

SEC.	TWP.	R.
32	26	39W ✓

WELL NO.

1 Heltemes "B"

FARM

COMPANY

Stanolind

CONTRACTOR

Hugoton Pool


150 Ft. from N. Line

Ft. from S. Line

150 Ft. from E. Line

Ft. from W. Line

NE SW

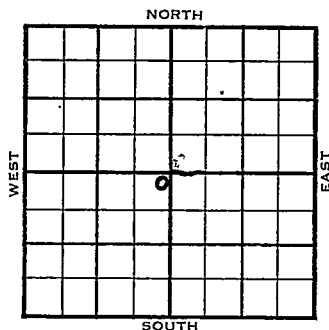

1953

ELEVATION

3299'

REPORT

10/28

Spud 10-23-53
8" @ 606'

Drlg. 2175'

11/4

RTD 2589'

Schl

5" @ 2582'

Her. Kr. 2407, Win 2461, Up Ft. 2527,
Low Ft. 2582,

CO 2589 DD 2607 frac. 64/ 2407-23

60/ 2426-36 102/ 2461-78 90/ 2482-97

30/ 2517-22 96/ 2528-44 66/ 2546-67

24/ 2560-64

11/11

Spud 10-23-53

Gas Well

TD 2607'

8" @ 606'

Her. 2407', Win. 2461, Ft. Riley
2527'

TD 2589'

5" @ 2582'

CO to 2589, DD 2607, frac

64/2407-23, 60/2426-36, 102/2461-78,

90/2482-97, 30/2517-22, 96/2528-44,

66/2546-67, 24/2560-64, frac

Comp. 9,601,000 cfgpd, 404#

COMPLETED

County Hamilton State Kansas

Sec. 32 (Blk. Twp.) 26 (Sur. Rge.) 39W Map No.

Operator Stanolind

Well No. 1 Farm Heltemes "B"

Elev. _____ Location NE SW

FIRST REPORT					
		D			

150 Ft. From N Line SW

150 Ft. From E Line Quarter

1st. Report OCT 28 1953

Completion _____

Remarks _____

Spudding Date 10-23-53

Drlg. Data Hugoton Pool

8" @ 606 drlg. 2175

