

KANSAS

Kearny

Section 32 Township 26  
22 Range 36WWell No. 1 EarlougherCompany Northern Natural Gas

Hugoton

NORTH

WEST

|  |  |  |  |  |  |  |  |
|--|--|--|--|--|--|--|--|
|  |  |  |  |  |  |  |  |
|  |  |  |  |  |  |  |  |
EAST

SOUTH

KANSAS

Kearny

Sec. 32 Twp. 22 26 R. 36WWell No. #1 Earlougher FarmNorthern Natural Gas Company

Hugoton Pool

Ft. from N. Line

330'


Ft. from S. Line

Ft. from E. Line

100'

Ft. from W. Line

SW NE

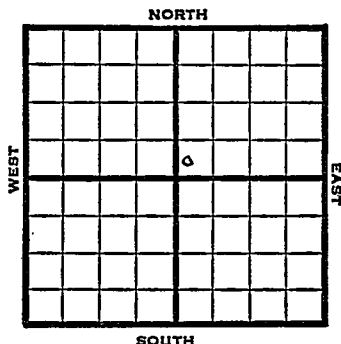

1949

Elev 3088' REPORT

|       |                                                                 |
|-------|-----------------------------------------------------------------|
| 8/10  | Location                                                        |
| 8/17  | "                                                               |
| 8/31  | TD 2678'                                                        |
|       | 271' of 5" Perf Liner @ 2678'                                   |
| 9/7   | "                                                               |
| 9/14  | "                                                               |
| 9/21  | Pulled 271 of 5" liner and ran 312' of 5" Perf liner @ 2731' TD |
| 9/28  | 2000 acid                                                       |
| 10/5  | "                                                               |
| 10/12 | TD 2731'                                                        |
|       | 7" @ 2424'                                                      |
|       | 312' of 5" Perf Liner @ 2731                                    |
|       | 22000 acid                                                      |
|       | 14,892,000 Gas                                                  |
|       | 412# R Pr.                                                      |
|       | Comp                                                            |

COMPLETED

Kansas

Map No. \_\_\_\_\_ Sec. 32 Twp. 22 R. 36W

Well No. 1 Earlougher

Northern Natural Gas

Company

Contractor

SW NE

## FIRST SECTION PLAT

\_\_\_\_\_ Ft. from N. Line

330 \_\_\_\_\_ Ft. from S. Line

\_\_\_\_\_ Ft. from E. Line

100 \_\_\_\_\_ Ft. from W. Line

|  |  |  |  |
|--|--|--|--|
|  |  |  |  |
|  |  |  |  |
|  |  |  |  |
|  |  |  |  |
|  |  |  |  |

Kearny County

## RECORD

Location X

Cased \_\_\_\_\_ in., \_\_\_\_\_ ft.

Rig up \_\_\_\_\_

Sand \_\_\_\_\_

Drilling and Remarks:

Gas \_\_\_\_\_

Oil \_\_\_\_\_

Total Depth \_\_\_\_\_

## PRODUCTION

1st 24 hrs. Nat. \_\_\_\_\_

1st 24 hrs. after shot \_\_\_\_\_

Gas \_\_\_\_\_ Cu. Ft.

Dry Hole \_\_\_\_\_

Abandoned \_\_\_\_\_

Date

AUG 10 1949 19 S I LEWIS Scout

Map No. \_\_\_\_\_ Sec. 32 Twp. 26 R. 36W

Well No. 1 Earlougher


Northern Natural Gas Company

**CORRECTION**

Contractor

SW NE

**SECTION PLAT**

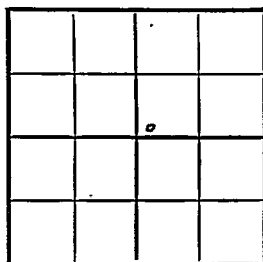

\_\_\_\_\_ Ft. from N. Line

330 \_\_\_\_\_ Ft. from S. Line

\_\_\_\_\_ Ft. from E. Line

330 \_\_\_\_\_ Ft. from W. Line

Kearny County

Location \_\_\_\_\_

Rig up \_\_\_\_\_

Drilling and Remarks:

Reported

32-22-36W

**RECORD**

Cased \_\_\_\_\_ in., \_\_\_\_\_ ft.

Sand \_\_\_\_\_

Gas \_\_\_\_\_

Oil \_\_\_\_\_

Total Depth \_\_\_\_\_

**PRODUCTION**

1st 24 hrs. Nat. \_\_\_\_\_

1st 24 hrs. after shot \_\_\_\_\_

Gas \_\_\_\_\_ Cu. Ft.

Dry Hole \_\_\_\_\_

Abandoned \_\_\_\_\_

Date

AUG 17 1949 19

S. J. LEWIS Scout

Map No. \_\_\_\_\_ Sec. 32 Twp. 26 R. 36W

Well No. 1 Earlougher

Northern Natural Gas Company

**COMPLETE**

Contractor

SW NE


*E 1, 2088*  
**SECTION PLAT**

\_\_\_\_\_ Ft. from N. Line

330 Ft. from S. Line

\_\_\_\_\_ Ft. from E. Line

100 Ft. from W. Line

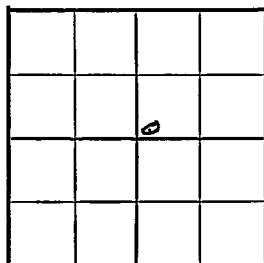

Kearny County

Location \_\_\_\_\_

Rig up \_\_\_\_\_

Drilling and Remarks:

*7" @ 2424*  
*2 1/2' of 3' Pay layer*  
*@ 2731*  
*22000 acid*  
*14,892 000 Gas*  
*4 1/2" R/P*

**RECORD**

Cased \_\_\_\_\_ in., \_\_\_\_\_ ft.

Sand \_\_\_\_\_

Gas \_\_\_\_\_

Oil \_\_\_\_\_

Total Depth 2731

**PRODUCTION**

1st 24 hrs. Nat. \_\_\_\_\_

1st 24 hrs. after shot \_\_\_\_\_

Gas \_\_\_\_\_ Cu. Ft.

Dry Hole \_\_\_\_\_

Abandoned \_\_\_\_\_

Date

OCT 12 1949 19

**S. J. LEWIS**

Scout