

KANSAS

Finney


FORM 51 IOM 12-46 PETROL

Section 32 Township 26 Range 34-W

Well No. 6 Jones

Company Helmerich & Payne

Hugoton Pool

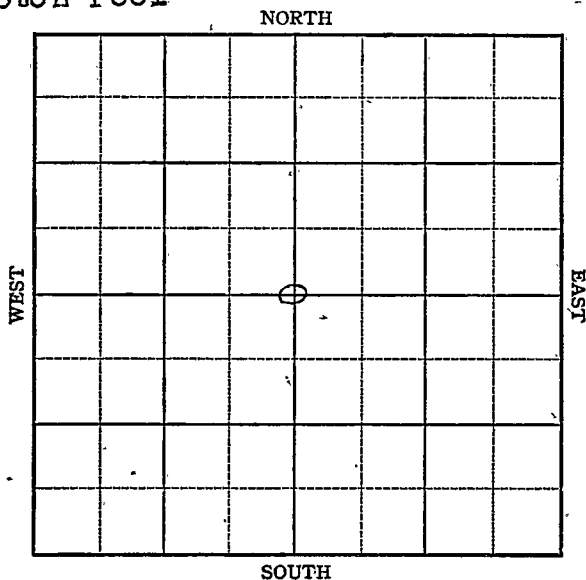

KANSAS

Finney

Sec. 32 Twp. 26 R. 34W

Well No. 6 Jones Farm

Helmerich & Payne Company

Hugoton Pool


2640 Ft. from N. Line

 Ft. from S. Line

2640 Ft. from E. Line

 Ft. from W. Line

C Sec.

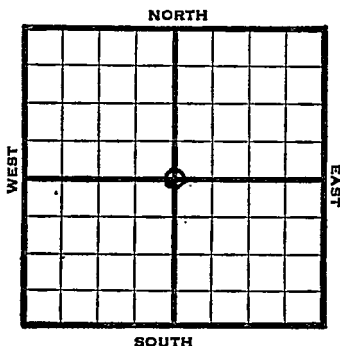

1947

REPORT

8/13	RUR
8/20	10" @ 750' Dr1g 1100'
8/27	TD 2492' 7" @ 2483'
9/3	" "
9/10	Dr1g. 2600'
9/17	TD 2764' 251' of 5" Perf. liner @ 2764' 15000 acid.
9/24	" "
10/1	" "
10/8	7" @ 2483' 251' of 5" Perf liner @ 2492 15,000 Acid 4,900,000 Gas TD 2492' 400# R Pr.

COMPLETED

Map No. _____ Sec. 32 Twp. 26 R. 34W

Well No. 6 Jones

Helmerich & Payne Company

FIRST REPORT Contractor

C Sec.


SECTION PLAT

2640 Ft. from N. Line

_____ Ft. from S. Line

2640 Ft. from E. Line

_____ Ft. from W. Line

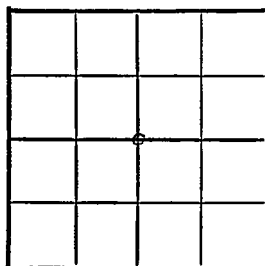

Finney County

Location _____

Rig up _____

Drilling and Remarks:

R U R

RECORD

Cased _____ in., _____ ft.

Sand _____

Gas _____

Oil _____

Total Depth _____

PRODUCTION

1st 24 hrs. Nat. _____

1st 24 hrs. after shot _____

Gas _____ Cu. Ft.

Dry Hole _____

Abandoned _____

Date

AUG 13 1947

19

S. J. LEWIS

Scout


Map No. 0 Sec. 32 Twp. 26 R. 34W

Well No. 6 Jones

Helmerich & Payne Company

COMPLETE Contractor
C Sec.

SECTION PLAT

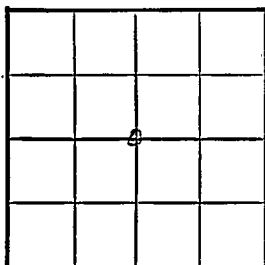

2640 Ft. from N. Line

 Ft. from S. Line

2640 Ft. from E. Line

 Ft. from W. Line

Finney County

Location

Rig up

Drilling and Remarks:

7" @ 2483

251' of 5" Payliner
@ 2492.

15000 acd/c

4,900,000 Gas

420 # R.P.

RECORD

Cased in., ft.

Sand

Gas

Oil

Total Depth 2492

PRODUCTION

1st 24 hrs. Nat.

1st 24 hrs. after shot

Gas Cu. Ft.

Dry Hole

Abandoned

, Date

OCT 8 1947

19

S. J. LEWIS Scout