


KANSAS

Finney

Section 32 Township 26S Range 33WWell No. #1 AtkinsCompany Magnolia

NORTH

WEST

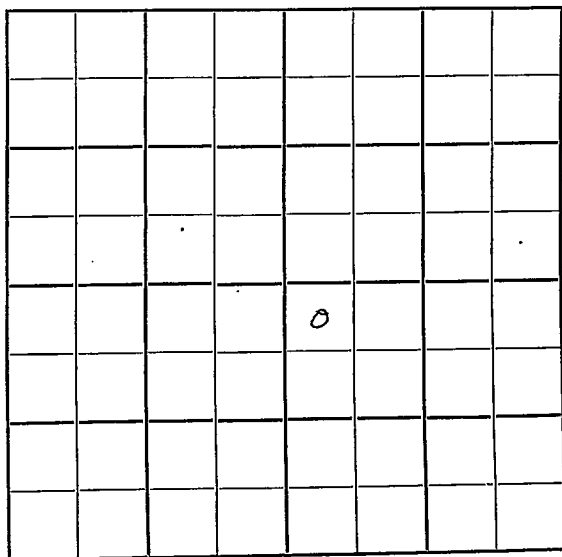

EAST

SOUTH

KANSAS

Finney

Sec. 32 Twp. 26 R. 33-W

Well No. #1 Atkins Farm

Magnolia Company


Hugoton

330 Ft. from N. Line

_____ Ft. from S. Line

_____ Ft. from E. Line

330 Ft. from W. Line

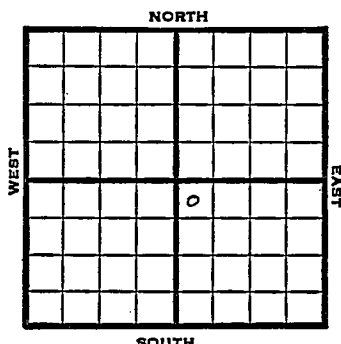

NW SE

1949

Elev 2937'

R E P O R T

10/12

Location

10/19

10" @ 868'

10/26

Drlg. 2675'

11/1

"

11/9

TD 2804'

6" @ 2800'

240 shots 2618-2677

24000 acid

11/16

144 shots 2568-2610

14000 acid

11/23

"

11/29

"

12/7

" "

12/14

"

12/21

TD 2804'

6" @ 2800'

Perf

38000 acid

5,010,000 Gas

395# R Pr.

Comp

COMPLETED

Map No. _____ Sec. 32 Twp. 26 R. 33W

Well No. 1 Atkins

Magnolia Company

Contractor

NW SE

FIRST REPORT
SECTION PLAT

330 Ft. from N. Line

_____ Ft. from S. Line

_____ Ft. from E. Line

330 Ft. from W. Line

		o	

Finney County

Location X

Rig up

Drilling and Remarks:

RECORD

Cased _____ in., _____ ft.

Sand _____

Gas _____

Oil _____

Total Depth _____

PRODUCTION

1st 24 hrs. Nat. _____

1st 24 hrs. after shot _____

Gas _____ Cu. Ft.

Dry Hole _____

Abandoned _____

Date

OCT 12 1949 19 S. J. LEWIS Scout

Map No. _____ Sec. 32 Twp. 26 R. 33W

Well No. 1 Atkins

Magnolia Company

COMPLETE

Contractor

NW SE


E 12987
SECTION PLAT

330 Ft. from N. Line

_____ Ft. from S. Line

_____ Ft. from E. Line

330 Ft. from W. Line

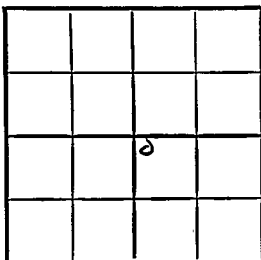

Finney County

RECORD

Location _____

Cased _____ in., _____ ft.

Rig up _____

Sand _____

Drilling and Remarks:

Gas _____

Oil _____

Total Depth 2804

PRODUCTION

1st 24 hrs. Nat. _____

1st 24 hrs. after shot _____

Gas _____ Cu. Ft.

Dry Hole _____

Abandoned _____

Date

DEC 21 1949 19

S. J. LEWIS Scout