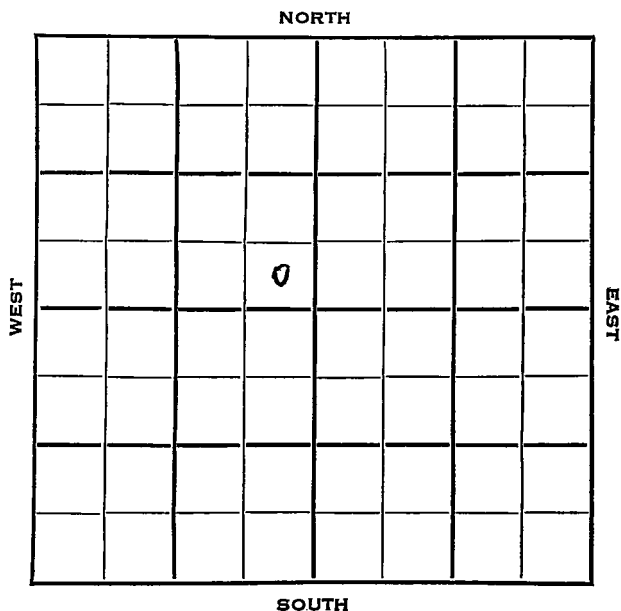


Section 33 Township 26 Range 39 WWell No. # 1 Trussell "C"Company Stanolind

Hamilton KANSAS		
SEC.	TWP.	R.
33	26	39 W
WELL NO.		
# 1 Trussell "C"		FARM
COMPANY		
Stanolind		
CONTRACTOR		

Hugoton Pool


_____ Ft. from N. Line

300 _____ Ft. from S. Line

300 _____ Ft. from E. Line

_____ Ft. from W. Line

SE SE NW

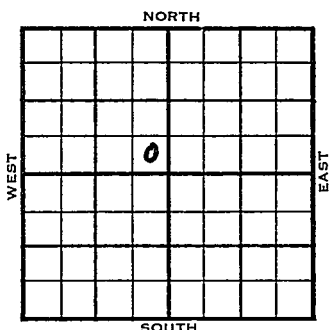

	ELEVATION	REPORT
1953	3248'	
10/21	Spud 10-18-53	
	8" @ 606	WOC
10/28	RTD 2554'	
	Schl	
	5" @ 2509'	
	Her. Kr. 2350', Win 2407', Up Ft.	
	2470', Low Ft 2529'	
	CO 2554'	
11/4	190/ 2350-82	102/ 2407-24 72/ 2428-40,
	24/ 2450-58	156/ 2474-2500 36/
	2502-08	sd-frac.
11/11	Spud 10-18-53	
	Gas Well	
	TD 2554'	
	8" @ 606'	
	Her. 2360, Win 2407', Ft. Riley 2470'	
	TD 2554'	
	5" @ 2509'	
	CO to 2554, 190/2350-82, 102/2407-24,	
	72/2428-40, 24/2450-58, 156/2474-2500,	
	36/2502-08	
	Sd-frac	
	Comp. 10,441,000 cfcpd, 402#	
	COMPLETED	

County Hamilton State Kansas

Sec. **33** (Blk. **26** (Sur. **39W** Map No.

Operator Stanolind

Well No. 1 Farm Trussell "C"

Elev.	Location	SE	SE	NW
-------	----------	----	----	----

0

FIRST REPORT

300 Ft. From S Line NW

300 Ft. From E Line Quarter

1st. Report OCT 21 1953

Completion _____


Remarks

Spudding Date **10-18-53**

Drlg. Data Hugoton Pool

8th @ 606 WOC

J. G. McGEHEE

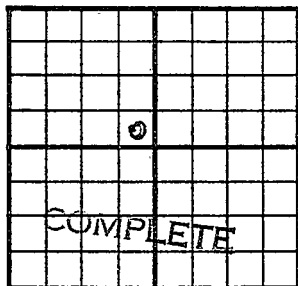County Hamilton State KansasSec. 33 (Blk. Twp.) 26 (Sur. Rge.) 39W Map No.Operator StanolindWell No. 1 Farm Trussell "C"Elev. 3248 Location SE SE NW

300Ft. From S Line NW

300Ft. From E Line Quarter

1st. Report

Completion NOV 11 1953

Remarks Hugoton PoolSpudding Date 10-18-53

Drig. Data Gas well TD 2554

8" @ 606 Her. 2360 Win. 2407

Ft. Riley 2470 TD 2554 5" @ 2509

CO to 2554 190/ 2350-82 102/ 2407-24

72/ 2428-40 24/ 2450-58 156/ 2474-2500

36/ 2502-08 sd-frae

Comp. 10,441,000 cf gpd 402#

J. G. McGEHEE