


Section 34 Township 26 Range 39W

Well No. #1 R. V. Fegan "B"

Company Stanolind

NORTH

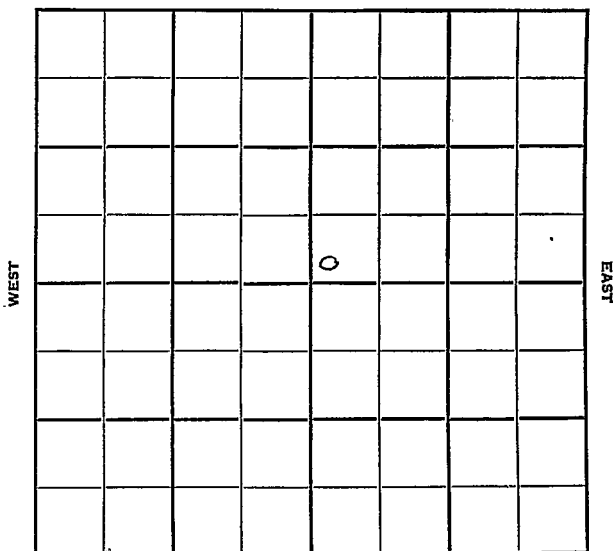

SOUTH

Sec. 34 Twp. 26 R. 39W

Well No. #1 R. V. Fegan "B" Farm

Stanolind Company

Contractor

**Hugoton Pool**


         Ft. from N. Line

150 Ft. from S. Line

         Ft. from E. Line

150 Ft. from W. Line

SW NE

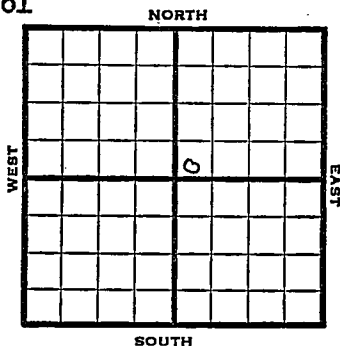

1952

Elev. 3251'

**REPORT**

7/30

Location

8/6

"

8/13

"

8/20

10" @ 586

8/27

Her. 2383 Winfield 2443  
Towanda 2505 Ft. Riley 2560  
RTD 2585 6" @ 2560'

9/3

CO 2585 2500 A  

9/10

NR

9/17

Spud 8-13-52  
Gas well TD 2585' 10" @ 586  
Her 2383' Win 2443' Towanda 2505'  
Ft. Riley 2560' TD 2585' 6" @ 2560  
CO to 2585 90/2387-96 42/2399-2406  
18/2413-16 24/2422-26 ~~12/2401-88~~  
12/2443-55 24/2457-61 24/2468-72  
12/2481-83 18/2495-98 36/2505-11  
24/2514-18 12/2520-22 54/2524-33  
36/2537-43 31,500 A  
Comp. 11,389,000 gas. 390#

**COMPLETED**



