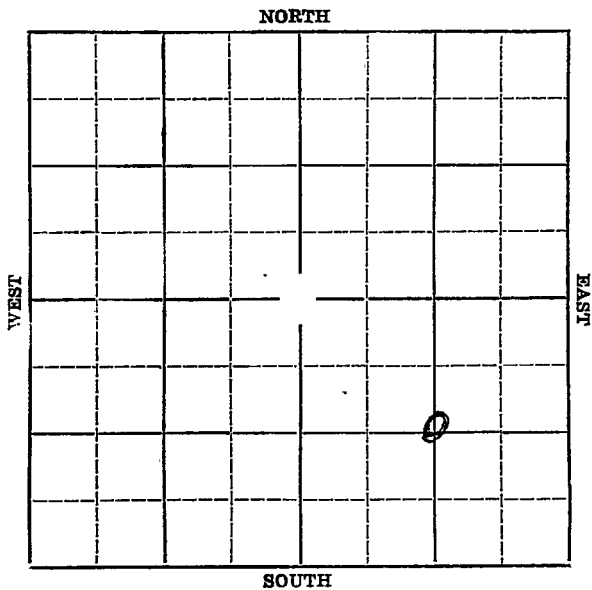


Form 51-5M-4-36-Palace

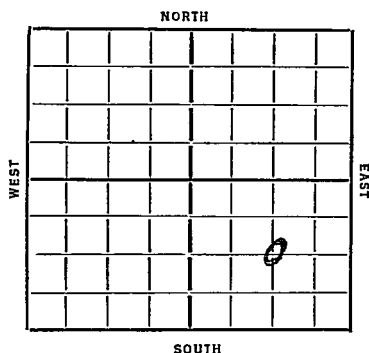
Section 34 Township 26 Range 34-WWell Number 1-JonesCompany Helmerick & Payne

Map No. **KANSAS** Sec. **34** Twp. **26** R. **34-W**Well No. **1-Jones** Farm**Helmerick & Payne** Company

Ft. from N. Line

1320 Ft. from S. Line**1320** Ft. from E. Line

Ft. from W. Line

Elev 2975Date
1936

REPORT

4/22 Location**4/30** Rig.**5/7** -- **5/14** -- **5/21** -- **5/28** -- **6/4** -- **6/11** --**6/18** Spud.**6/25** 10" @ 645'. Waiting on cement.**7/2** Drlg. 2000'.**7/9** No report.**7/16** Dolomite 2507'. 6" @ 2515'. RUST.**7/23** --**7/20** Drlg. 2530'.**8/6** No report.**8/13** Drlg. 2610'.**8/20** --**8/27** Gas sand 2570'. Drlg. 2759'.

Estimate 4 million cuft of gas.

9/3 --**9/23** / **36** - Dolomite 2507'.~~2000~~ x T.D. 2764'.

2000 gallons of acid.

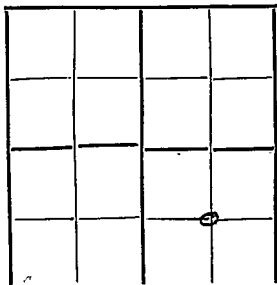
 $3\frac{1}{4}$ million gas s.

460# R. Pressure.

COMPLETED

KANSASMap No. No Map Sec. 34 Twp. 26 R. 34WWell No. JonesH. S. Erick & Payne Company

Contractor

SECTION PLAT

.....Ft. from N. Line ,

1320 Ft. from S. Line1320 Ft. from E. Line

.....Ft. from W. Line

FIRST REPORTLocation.....✓

Rig up.....

Drilling and Remarks:

RECORD

Cased.....in.,ft.

Sand.....

Gas.....

Oil.....

Total Depth.....

PRODUCTION

1st 24 hrs. Nat.....

1st 24 hrs. after shot.....

Gas.....Cu. Ft.

Dry Hole.....

Abandoned.....

Date

APR 22 1936

192.....

S. J. L. E

Scout

KANSAS

Map No. W 14 22 Sec. 34 Twp. 26 R. 34 WWell No. 1 Jones.H. M. M. & Payne. Company

Contractor

SECTION PLAT

_____ Ft. from N. Line

1320 Ft. from S. Line1320 Ft. from E. Line

_____ Ft. from W. Line

COMPLETED

Location _____

Rig up _____

Drilling and Remarks:

Dolomite 25072000 acid3 1/4 M Gas.460# R. P.

RECORD

Cased _____ in., _____ ft.

Sand _____

Gas _____

Oil _____

Total Depth 2764

PRODUCTION

1st 24 hrs. Nat. _____

1st 24 hrs. after shot _____

Gas _____ Cu. Ft.

Dry Hole _____

Abandoned _____

Date

SEP 23 1936S. J. LEWIS

Scout