

Kearny


ANSAS

FORM 51 IOM 12-46 PETROL

Section 34 Township 26 Range 35W

Well No. 6 Bldg. & Loan

Company Helmerich & Payne

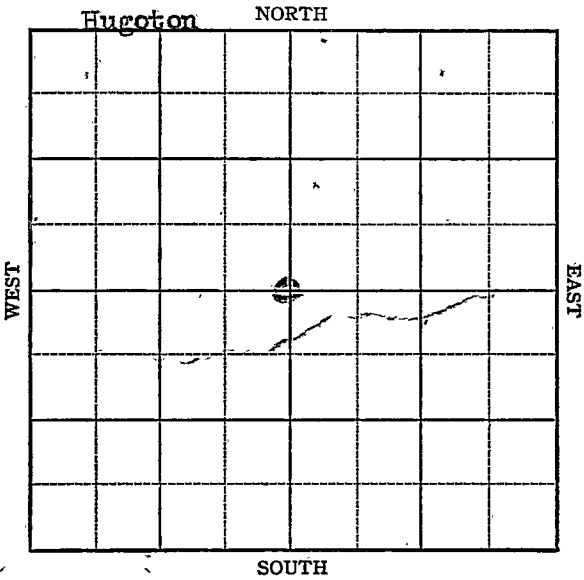

KANSAS

Kearny County

Sec. 34 Twp. 26 R. 35- W

Well No. 6 Bldg. & Loan Farm

Helmerich & Payne Company


Hugoton Pool

2640 Ft. from N. Line

Ft. from S. Line

2640 Ft. from E. Line

Ft. from W. Line

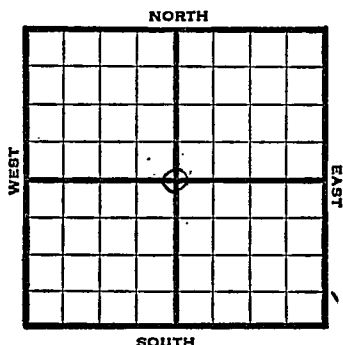

C Sec.-

1947	Elev. -	REPORT
7/30	RUR Drlg 2365'	(Report)
8/6	10" @ 795' 7" @ 2541' TD 2558' T.D. 2569'	
8/13	TD 2753 1000 acid	
8/20	5000 Acid	
8/27	"	
9/3	"	
9/10	"	
9/17	7" @ 2541' 2000 Acid 14,880,000 Gas 397# Rock Pressure Total Depth 2753'	
	COMPLETED	

KansasMap No. _____ Sec. 34 Twp. 26 R. 35WWell No. 6 Bldg. & Loan _____

_____ Helmerich & Payne. _____ Company

FIRST REPORT

_____ Contractor

C Sec.


SECTION PLAT

2640 Ft. from N. Line

_____ Ft. from S. Line

2640 Ft. from E. Line

_____ Ft. from W. Line

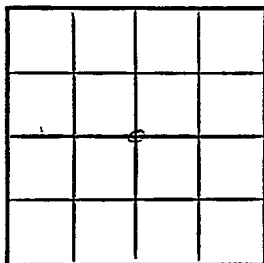

Kearny County

Location _____

Rig up _____

Drilling and Remarks:

R U R •

RECORD

Cased _____ in., _____ ft.

Sand _____

Gas _____

Oil _____

Total Depth _____

PRODUCTION

1st 24 hrs. Nat. _____

1st 24 hrs. after shot _____

Gas _____ Cu. Ft.

Dry Hole _____

Abandoned _____

Date

JUL 23 1947

19

J. LEWIS

Scout

Map No. 0 Sec. 34 Twp. 26 R. 35W

Well No. 6 Bldg. & Loan

Helmerich & Payne Company

COMPLETE Contractor

C Sec.


SECTION PLAT

2640 Ft. from N. Line

 Ft. from S. Line

2640 Ft. from E. Line

 Ft. from W. Line

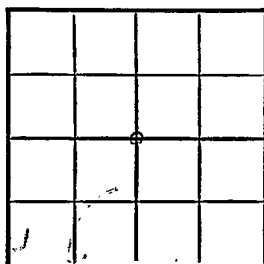

Kearny County

Location

Rig up

Drilling and Remarks:

*7' @ 2541
2000000 C
14,880,000 Gal*

RECORD

Cased in. ft.

Sand

Gas

Oil

Total Depth 2257

PRODUCTION

1st 24 hrs. Nat.

1st 24 hrs. after shot

Gas Cu. Ft.

Dry Hole

Abandoned

Date

SEP 17 1947 19

S. J. LEWIS Scout