


Section 34 Township 26 Range 33W
 Well No. #1 Atkins "K"
 Company Cities Service

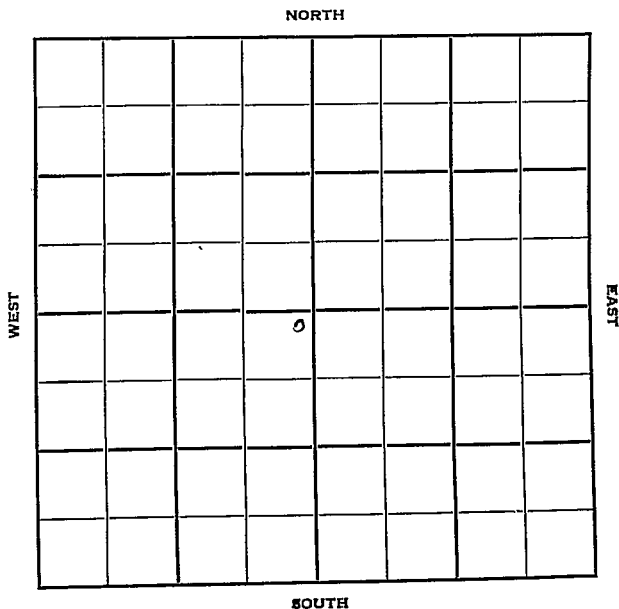

Sec. 34 Twp. 26 R. 33W

Well No. #1 Atkins "K" Farm

Cities Service

Company

Corbett & Barber

Contractor


Hugoton Pool

100' Ft. from N. Line

Ft. from S. Line

100' Ft. from E. Line

Ft. from W. Line

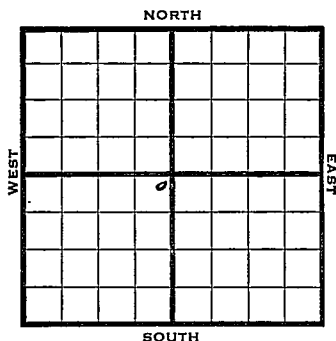

NE SW

1949

Elev 2927'

REPORT

11/2	Location
11/9	8" @ 759'
	Drlg 2180'
11/16	TD 2770'
	5" @ 2769'
11/23	240 shots 2615-2740
11/29	29000 acid
12/7	"
12/14	"
12/21	TD 2770'
	5" @ 2769'
	Perf
	29000 acid
	11,700,000 Gas
	411# R Pr.
	Comp

COMPLETED

Kansas

Map No. _____ Sec. 34 Twp. 26 R. 33WWell No. 1 Atikins "K"

Cities Service _____ Company

Corbett & Barber _____ Contractor


NE SW

FIRST REPORT
SECTION PLAT100 Ft. from N. Line

_____ Ft. from S. Line

100 Ft. from E. Line

_____ Ft. from W. Line

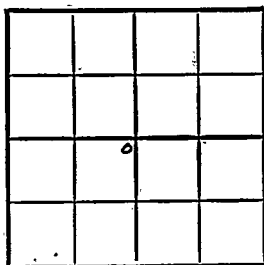

Finney County

Location X

Rig up _____

Drilling and Remarks:

RECORD

Cased _____ in., _____ ft.

Sand _____

Gas _____

Oil _____

Total Depth _____

PRODUCTION

1st 24 hrs. Nat. _____

1st 24 hrs. after shot _____

Gas _____ Cu. Ft.

Dry Hole _____

Abandoned _____

Date

NOV 2 1949 19

S. J. LEWIS Scout

Map No. _____ Sec. 34 Twp. 26 R. 33W

Well No. 1 Atikins "K"

Cities Service

Company

COMPLETE

Contractor

NE SW


E. 2927
SECTION PLAT

100 Ft. from N. Line

_____ Ft. from S. Line

100 Ft. from E. Line

_____ Ft. from W. Line

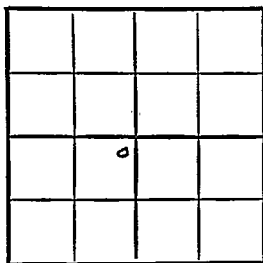

Finney County

Location _____

Rig up _____

Drilling and Remarks:

5' 2769

Perf.

29000 acid

11,700,000 Gas.

*411 * R 1/2*

RECORD

Cased _____ in., _____ ft.

Sand _____

Gas _____

Oil _____

Total Depth 2270

PRODUCTION

1st 24 hrs. Nat. _____

1st 24 hrs. after shot _____

Gas _____ Cu. Ft.

Dry Hole _____

Abandoned _____

Date

DEC 21 1949

19

S. J. LEWIS

Scout