


KANSASSection 35 Township 26 Range 34WWell No. #1 Barker-GreenslateCompany Magnolia

Hugoton pool

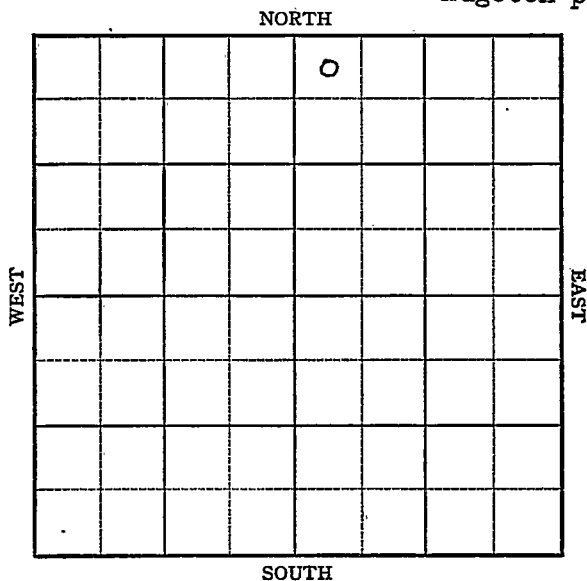

Sec. 35 Twp. 26 R. 34W

Well No. #1 Barker-Greenslate Farm

Magnolia

Company

Hugoton Pool


330' Ft. from N. Line

_____ Ft. from S. Line

_____ Ft. from E. Line

330' Ft. from W. Line

NW NE

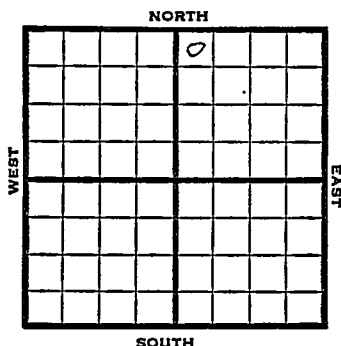

1949 Elv. 2972 DF REPORT

8/17 Location

8/24 "

8/31 "

9/7 "

9/14 10" @ 828'

9/21 Drlg. 2770'

9/28 TD 2820'

7" @ 2819'

10/5 "

10/12 "

10/19 96 shots 2716-34

7000 acid

10/26 296 shots 2551-2641

28000 acid

11/1 "

11/9 TD 2820'

7" @ 2819'

Perf 35000 acid

35,380,000 Gas

395# R Pr.

Comp

COMPLETED

Map No. _____ Sec. 35 Twp. 26 R. 34W

Well No. 1 Barker-Greenslate

Magnolia _____ Company

Contractor

NW NE

FIRST REPORT
SECTION PLAT

330 Ft. from N. Line

_____ Ft. from S. Line

_____ Ft. from E. Line

330 Ft. from W. Line

		6	

Finney County

Location X

Rig up _____

Drilling and Remarks:

RECORD

Cased _____ in., _____ ft.

Sand _____

Gas _____

Oil _____

Total Depth _____

PRODUCTION

1st 24 hrs. Nat. _____

1st 24 hrs. after shot _____

Gas _____ Cu. Ft.

Dry Hole _____

Abandoned _____

Date

AUG 17 1949 19 _____ S. J. LEWIS Scout

Kansas

Hugoton Pool

Map No. _____ Sec. 35 Twp. 26 R. 34W

Well No. 1 Barker - Greenslate

Magnolia Company

COMPLETE

Contractor

NW NE


E12972
SECTION PLAT

330 Ft. from N. Line

Ft. from S. Line

Ft. from E. Line

330 Ft. from W. Line

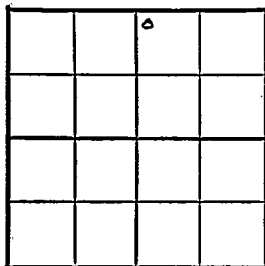

Finney County

Location _____

Rig up _____

Drilling and Remarks:

7" C 2879

Perf.

35,000 acid

35,320,000 Gas

095* R 12

RECORD

Cased _____ in., _____ ft.

Sand _____

Gas _____

Oil _____

Total Depth 2820

PRODUCTION

1st 24 hrs. Nat. _____

1st 24 hrs. after shot _____

Gas _____ Cu. Ft.

Dry Hole _____

Abandoned _____

Date

NOV 9 1949

19

S. J. LEWIS

Scout