

KANSAS

FORM 51 IOM 12-46 PETROL


Section 35 Township 26 Range 35-W

Well No. ~~1-Petroleum~~ #7 Building & Loan

Company Helmerich & Payne et al

Hugoton Pool

NORTH

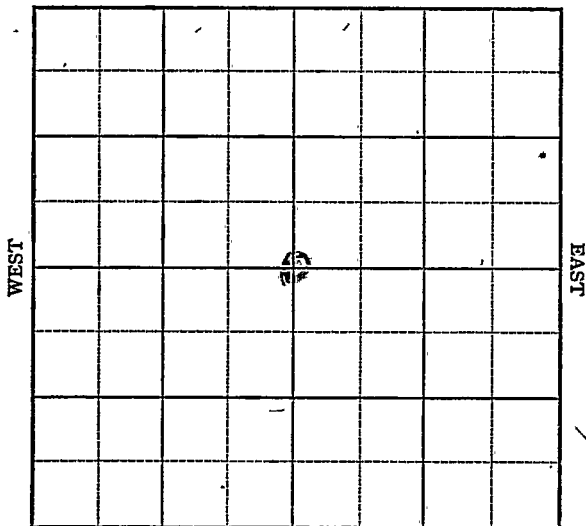

SOUTH

Sec. 35 Twp. 26 R. 35-W

Well No. #1 Potter 7 Building & Loan Farm

Helmerich & Payne et al Company

Hutotom POOL


2640 Ft. from N. Line

 Ft. from S. Line

2640 Ft. from E. Line

 Ft. from W. Line

C Sec.

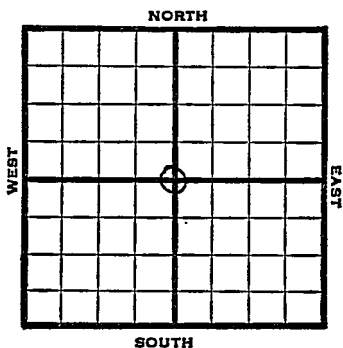

1947 Elev. 3028' REPORT

7/2	R U R
7/8	"
7/16	10" @ 796' Drlg 1825'
7/22	TD 2798 7" @ 2798
7/30	"
8/6	"
8/13	"
8/20	"
8/27	"
9/3	"
9/10	"
9/17	"
9/24	"
10/1	"

OVER

1947

10/8 7" @ 2793'

Perf.

17,000 Acid

16,172,000 Gas

TD 2798'

417# R Pr.

COMPLETE

Map No. _____ Sec. 35 Twp. 26 R. 35W

Well No. 1 Potter

Helmerich & Payne et al. Company

FIRST REPORT Contractor

C Sec.


SECTION PLAT

2640 Ft. from N. Line

_____ Ft. from S. Line

2640 Ft. from E. Line

_____ Ft. from W. Line

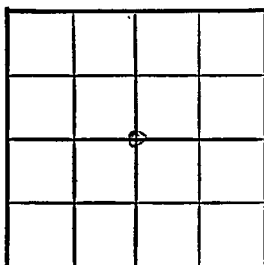

Kearny County.

Location _____

Rig up _____

Drilling and Remarks:

R U R

RECORD.

Cased _____ in., _____ ft.

Sand _____

Gas _____

Oil _____

Total Depth _____

PRODUCTION

1st 24 hrs. Nat. _____

1st 24 hrs. after shot _____

Gas _____ Cu. Ft.

Dry Hole _____

Abandoned _____

Date

JUL 2 1947

S. J. LEWIS

Scout

Misc. Small Maps	<i>[initials]</i>
Cards	<i>[initials]</i>
Tracing	
France Map	<i>[initials]</i>
Scarborough Map	<i>[initials]</i>
Pierce Map	
Geological Dept.	
Pierce Plat Book	

Map No. _____ Sec. 35 Twp. 26 R. 35W

Well No. 7 Building & Loan


Helmerich & Payne et al. Company

CORRECTION

Contractor

C Sec.

SECTION PLAT

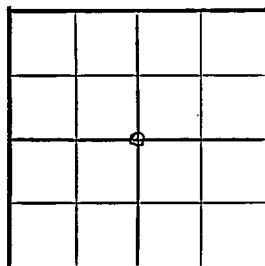

2640 Ft. from N. Line

_____ Ft. from S. Line

2640 Ft. from E. Line

_____ Ft. from W. Line

Kearny County

Location _____

Rig up _____

Drilling and Remarks:

Reported

#1 Potter

RECORD

Cased _____ in., _____ ft.

Sand _____

Gas _____

Oil _____

Total Depth _____

PRODUCTION

1st 24 hrs. Nat. _____

1st 24 hrs. after shot _____

Gas _____ Cu. Ft.

Dry Hole _____

Abandoned _____

Date

JUL 9 1947 19


S. J. LEWIS Scout

no index

Misc. Small Maps	
Cards	<i>MC</i>
Tracing	☒
France Map	☒
Scarborough Map	☒
Pierce Map	☒
Geological Dept.	
Pierce Plat Book	

Map No. 0 Sec. 35 Twp. 26 R. 35WWell No. 7 Bldg. & LoanHelmerich & Payne CompanyCOMPLETE Contractor

C Sec.

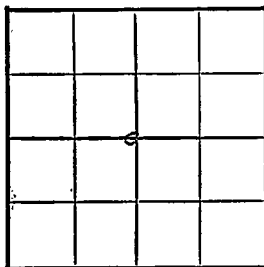E1,3028
SECTION PLAT2640 Ft. from N. Line Ft. from S. Line2640 Ft. from E. Line Ft. from W. LineKearny CountyLocation Rig up

Drilling and Remarks:

7" @ 2783Perf.17000 aciol16,172,000 Gas417 # RA

RECORD

Cased in., ft.Sand Gas Oil Total Depth 2798

PRODUCTION

1st 24 hrs. Nat. 1st 24 hrs. after shot Gas Cu. Ft.Dry Hole Abandoned

Date

OCT 8 1947 19 S. J. LEWIS Scout

Misc. Small Maps

Cards

Tracing

Trance Map

Seaborough Map

Pierce Map

Geological Dept.

Pierce Flat Dock