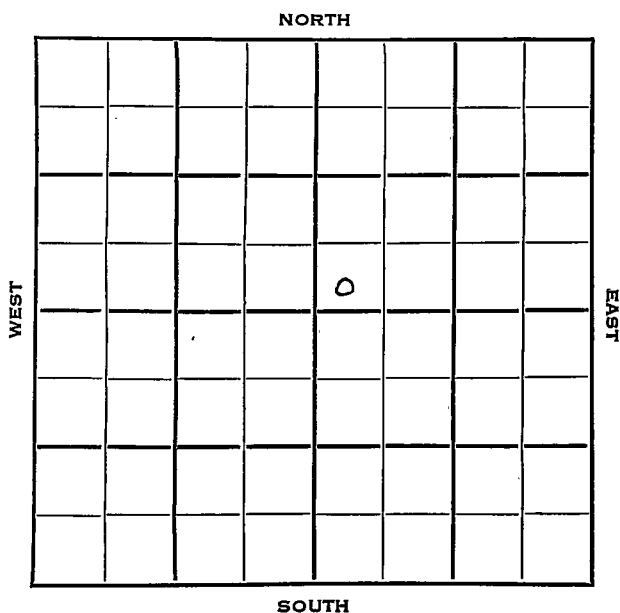


Section 35 Township 26 Range 33WWell No. 1 Kisner "B"Company Stanolind Oil and Gas Company

Sec. 35 Twp. 26 R. 33 WWell No. # 1 Kisner "B" FarmStanolind Company

Contractor


Ft. from N. Line

150 Ft. from S. Line

Ft. from E. Line

150 Ft. from W. Line

SW NE

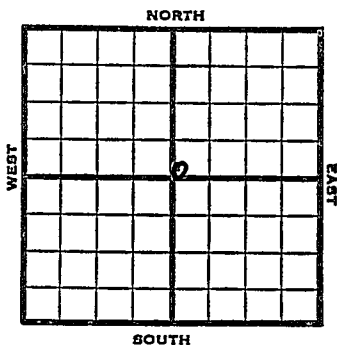

1953 Elev. 2924' REPORT

Location

1/21

1/29

2/5

2/12

8" @ 867

RTD 2755'

5" @ 2740

Her 2628, Win 2687, Up Ft.
2740

2/19

NR

2/26

N.R.

3/12

NR

3/18

Gas well TD 2760' 8" @ 867

TD 2755' 5" @ 2740 Her 2628'

Win. 2687' Ft. Riley 2740'

CO to 2755 DD 2760 2000 A

96/2628-44 12/2646-48 12/2651-53

12/2661-63 12/2667-69 42/2687-94

36/2698-2704 12/2712-14 18/2719-22

12/2727-29 19,500 A

Comp. 9,601,000 gas. 350#

COMPLETED

County Finney State Kansas

Sec. 35 (Blk. Twp.) 26 (Sur. Rge.) 33W Map No.

Operator Stanolind

Well No. 1 Farm Kisner "B"

Elev.	Location	SW	NE
-------	----------	----	----

0

FIRST REPORT

150 Ft. From S Line NE

150 Ft. From W Line Quarter

1st. Report JAN 21 1953

Completion

Remarks


Spudding Date _____

Drlg. Data

Location _____

J. G. McGEHEE

County Finney State Kansas
 Sec. 35 (Blk. 26) (Sur. 33W) Map No.
 Operator Stanolind
 Well No. 1 Farm Kisner "B"
 Elev. 2924 Location SW NE

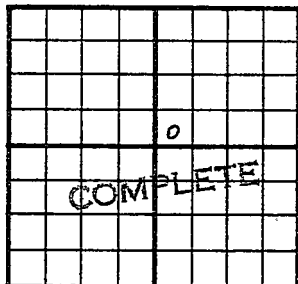

150 Ft. From S Line NE
150 Ft. From W Line Quarter

Ist. Report

Completion MAR 18 1953

Remarks

Spudding Date

Drlg. Data Gas well TD 2760
8" @ 867 TD 2755 5" @ 2740
Her. 2628 Win. 2687 Ft. Riley 2740
CO to 2755 DD 2760 2000 A 96/ 2628-44
12/ 2646-48 12/ 2651-53 12/ 2661-63
12/ 2667-69 42/ 2687-94 36/ 2698-2704
12/ 2712-14 18/ 2719-22 12/ 2727-29
19500 A Comp. 9,601,000 gas 350#

J. G. McGEHEE