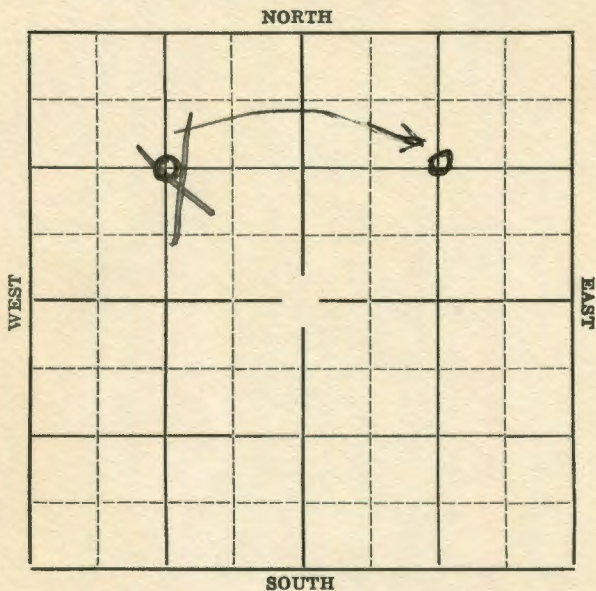


Section 1 Township 26 Range 36-W

Well Number 1 Masonic ^{Home}

Company Murphy

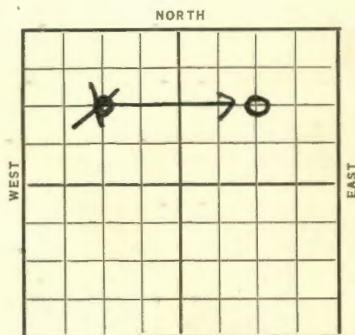


Sec. 1 Twp. 26 R. 36-WWell No. #1 Masonic Home. FarmMurphy

Company

1320 Ft. from N. Line

Ft. from S. Line

1320 Ft. from E. Line~~1320~~ Ft. from W. Line

SPECIAL SW NE NE Leowen

1937

REPORT

3/3	Rig
3/11	"
3/18	"
3/25	"
4/2	Rigging up.
4/8	" "
4/16	RU & SD
4/23	" "
4/30	" "
5/7	" "
5/14	" "
5/21	" "
5/28	12" @ 151'. Drlg. 500'.
6/4	" " " "
6/11	Fsg. @ 519'.
6/19	" "
6/25	Shut down.
7/2	" "
7/9	" "
7/16	" "
7/23	" "
7/30	" "

OVER

1937

8/6 Drlg. 1490'.
 8/13 T.D. 1500'. U. R. 8".
 8/20 Drlg. 1610'.
 8/28 T.D. 1610' Fsg.
 9/3 10" @ 808'. 8" @ 1465'.
 T.D. 1610' Fsg.
 9/10 " " "
 9/17 " " "
 9/24 SD 1468'.
 10/2 " "
 10/8 " "
 10/15 " "
 10/20 T.D. 1468'.

ABANDONED

KANSASMap No. No Map Sec. 1 Twp. 26 R. 36WWell No. 1 Masonic HomeMurphy Company

Contractor

Special**SECTION PLAT**

	○		

1320 Ft. from N. Line

_____ Ft. from S. Line

_____ Ft. from E. Line

1320 Ft. from W. Line**FIRST REPORT**

Location _____

Rig up _____

Drilling and Remarks:

Rig**RECORD**

Cased _____ in., _____ ft.

Sand _____

Gas _____

Oil _____

Total Depth _____

PRODUCTION

1st 24 hrs. Nat. _____

1st 24 hrs. after shot _____

Gas _____ Cu. Ft.

Dry Hole _____

Abandoned _____

Date

MAR 3 1937 19

S. J. LEWIS Scout

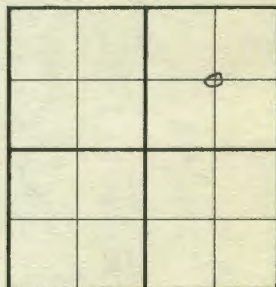
KANSAS

Hearney

Map No. NM Sec. 1 Twp. 26 R. 36W.Well No. 1 Maroon HomeMurphy Company

Contractor

SECTION PLAT

1320 Ft. from N. Line

_____ Ft. from S. Line

1320 Ft. from E. Line

_____ Ft. from W. Line

CORRECTION

Location _____

Rig up _____

Drilling and Remarks:

*Reported in
CNOV. and
should be
CNE*

RECORD

Cased _____ in., _____ ft.

Sand _____

Gas _____

Oil _____

Total Depth _____

PRODUCTION

1st 24 hrs. Nat. _____

1st 24 hrs. after shot _____

Gas _____ Cu. Ft.

Dry Hole _____

Abandoned _____

Date

MAR 24 1937

19

S. J. LEWIS Scout

Kerny

KANSAS

Map No. _____ Sec. 1 Twp. 26 R. 36WWell No. 1 Masonic HomeMurphy

Company _____

Contractor _____

ABANDONED

C NE

1320 Ft. from N. Line

_____ Ft. from S. Line

1320 Ft. from E. Line

_____ Ft. from W. Line

SECTION PLAT

Location _____

Rig up _____

Drilling and Remarks:

RECORD

Cased _____ in.; _____ ft.

Sand _____

Gas _____

Oil _____

Total Depth 1468

PRODUCTION

1st 24 hrs. Nat. _____

1st 24 hrs. after shot _____

Gas _____ Cu. Ft.

Dry Hole _____

Abandoned _____

Date

OCT 20 1937 19H. D. Hatfield Scout

DVA