


Section 36 Township 26 Range 37-W

Well No. #3 Broadhurst

Company Northern Natural

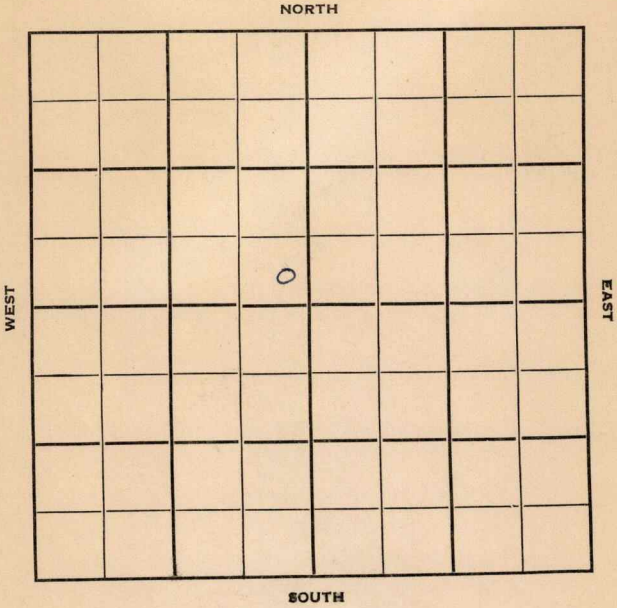

Kearny

KANSAS

Sec. 36 Twp. 26 R. 37W

Well No. #3 Broadhurst Farm

Northern Natural Company

Contractor

Hugoton


_____ Ft. from N. Line

200' Ft. from S. Line

200' Ft. from E. Line

_____ Ft. from W. Line

SE NW

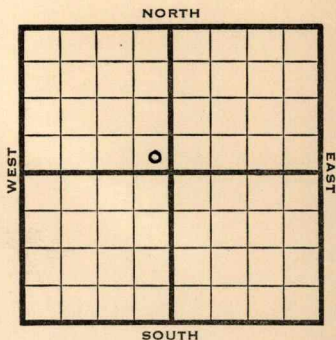

1950

Elev 3082

REPORT

8/9 Location

10/18 Spud 8-10-50

10" @ 401

7" @ 2433

TD 2680

Her 2420

Towanda 2551

Ft. Riley 2625

21000 total acid

Comp 17,351,000 gas

Completed

COMPLETED

