
FORM 51 25M 8-50 WESTERN Hamilton KANSAS

Section 36 Township 26 Range 40W

Well No. #2 Heltemes

Company United Prod.

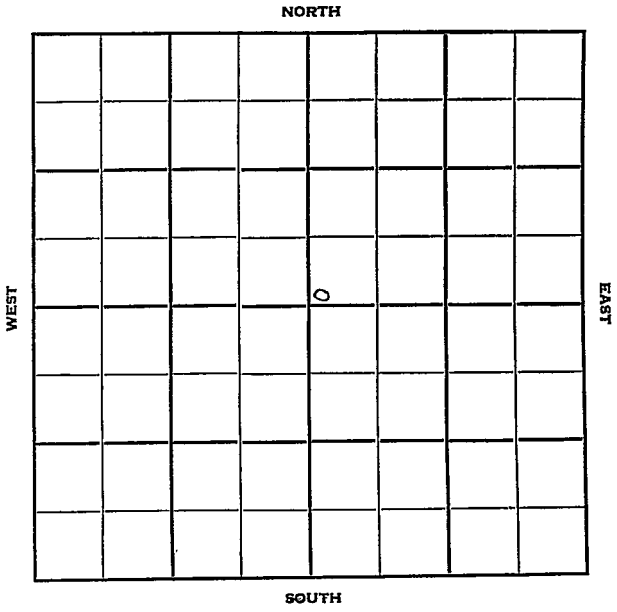

FORM 252-B
10M 11-50 PETROL

Hamilton KANSAS

Sec. 36 Twp. 26 R. 40W

Well No. #2 Heltemes Farm

United Prod. Company

Contractor

Hugoton Pool


Ft. from N. Line

150' Ft. from S. Line

Ft. from E. Line

150' Ft. from W. Line

SW SW NE

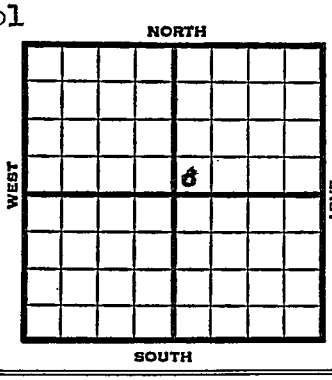

1951	Elev. 3297' REPORT
9/19	Location
11/7	Spud 9-18-51 Gas Well TD 2503 10" @ 467 7" @ 2364 TD 2503 Her. 2359 Kri 2375 Win. 2416 Ft. Riley 2485 6000 A Comp. 13,000,000 gas COMPLETED

FORM 275 FOR SALE BY KANSAS BLUE PRINT CO.


County Hamilton State Kansas

Sec. 36 (Blk. Twp.) 26 (Sur. Rge.) 40W Map No.

Operator United Prod.

Well No. 2 Farm ~~Heltmes~~ Heltemes

Elev. Location SW SW NE

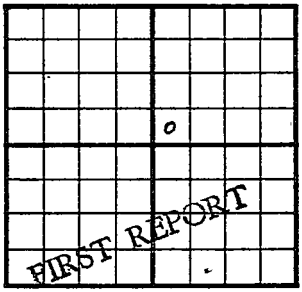

150 Ft. From S Line NE

150 Ft. From W Line Quarter

1st. Report SEP 19 1951

Completion

Remarks

Spudding Date

Drlg. Data Hugoton - pool

Location

J. E. TYRA

FORM 275 FOR SALE BY KANSAS BLUE PRINT CO.


County Hamilton State Kansas

Sec. 36 (Blk. Twp.) 2 6 (Sur. Rge.) 4 OW Map No.

Operator United Prod.

Well No. 2 Farm Heltemes

Elev. 3297 Location SW SW NE

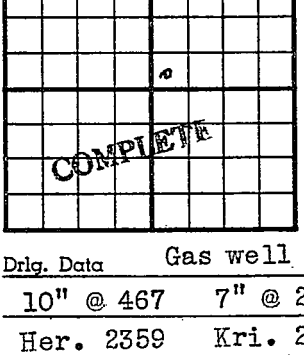

150 Ft. From S Line NE

150 Ft. From W Line Quarter

Ist. Report

Completion NOV 7 1951

Remarks Hugoton Pool

Spudding Date 9-18-51

Drlg. Data Gas well TD 2503

10" @ 467 7" @ 2364 TD 2503

Her. 2359 Kri. 2375 Win. 2416

Ft. Riley 2485 6000 A

Comp. 13,000,000 gas

J. E. TYRA