


Section 25
36 Township 26 Range 35-T

Well Number #2-Jones

Company Helmerick & Payne

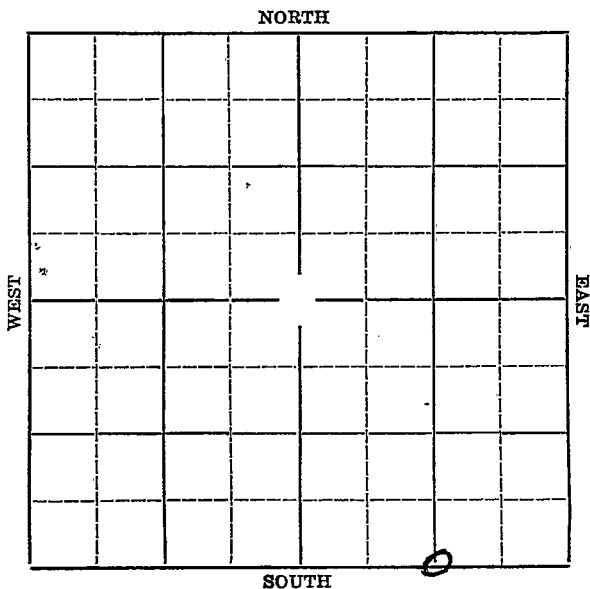

KANSAS

Kearny


 Sec. 25
36 Twp. 26 R. 35W
Well No. #2 Jones FarmHelmerick & Payne Company

_____ Ft. from N. Line

_____ Ft. from S. Line

1320' Ft. from E. Line

_____ Ft. from W. Line

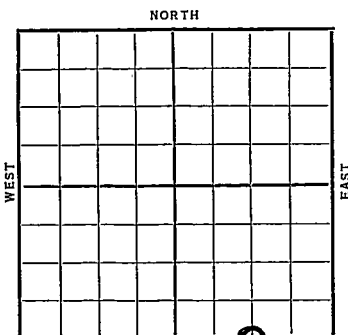

On the line between Sec. 25 & 36.

~~1936~~ 3027 REPORT

9/23 Rig.

10/1 --10/8-- 10/15--10/22--10/29--

11/6--11/12-- 11/19--11/27-- 12/3-

12/10---

12/17 Rig & tools.

12/24 " " " 12/29--

1937

1/7 8" @ 2625'. Drlg.

1/14 No report.

1/21 " "

1/28 1½ M gas 2760'. Drlg. 2762'.

2/4 3 M gas. Drlg. 2815'.

2/11 Shot 40 qts.

2/18 No test.

2/26 No Report

3/3 Sand 2625'.

T. D. 2815'.

P. B. 2761'.

2½ M gas.

COMPLETED

KAN. AG

Map No. No. 1710 Sec. 25 } Twp. 26 R. 35W.Well No. 2 JonesHelmick & Payne Company

Contractor

SECTION PLAT

_____ Ft. from N. Line

_____ Ft. from S. Line

1320 Ft. from E. Line

_____ Ft. from W. Line

FIRST REPORT

Location _____

Rig up _____

Drilling and Remarks:

*on the line
between 25
and 36*

Rig

RECORD

Cased _____ in., _____ ft.

Sand _____

Gas _____

Oil _____

Total Depth _____

PRODUCTION

1st 24 hrs. Nat. _____

1st 24 hrs. after shot _____

Gas _____ Cu. Ft.

Dry Hole _____

Abandoned _____

Date

SEP 23 1936

19

S. J. LEWIS

Scout



420


Returned _____
Cards _____
Tracing _____
France Map _____
Scarborough Map _____
Moody Map _____
Scarborough Plat Book _____
Moody Plat Book _____

KANSAS

Map No. Map Sec. 36-25 Twp. 26 R. 35W.Well No. 2 JonesHELMERICK & PAYNE Company

Contractor

SECTION PLAT

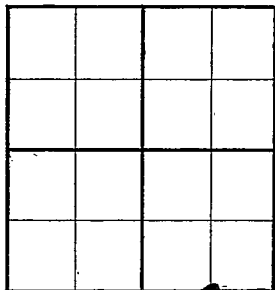

_____ Ft. from N. Line

_____ Ft. from S. Line

1320 Ft. from E. Line

_____ Ft. from W. Line

COMPLETED

Location _____

Rig up _____

Drilling and Remarks:

Sand 2625P.B 27612 1/2 M Gas

RECORD

Cased _____ in., _____ ft.

Sand _____

Gas _____

Oil _____

Total Depth 2815

PRODUCTION

1st 24 hrs. Nat. _____

1st 24 hrs. after shot _____

Gas _____ Cu. Ft.

Dry Hole _____


Abandoned _____

Date

MAR 3 1937 19

S. J. LEWIS Scout

no much map Paul

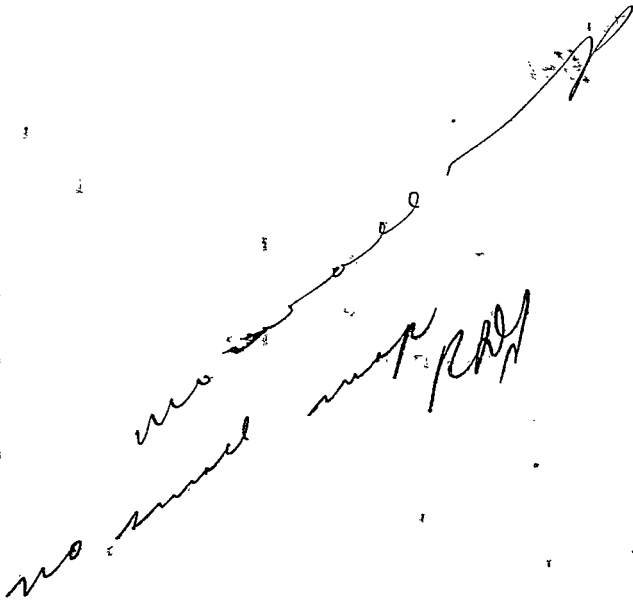

Returned	
Cards	 Paul
Tracing	 ✓
France Map	 ✓
Scarborough Map	 X
Moody Map	 ✓
Scarborough Plat Book	
Moody Plat Book	