


Section 8 Township 26 Range 37-W

Well No. #1 Waecher "B"

Company Stanolind

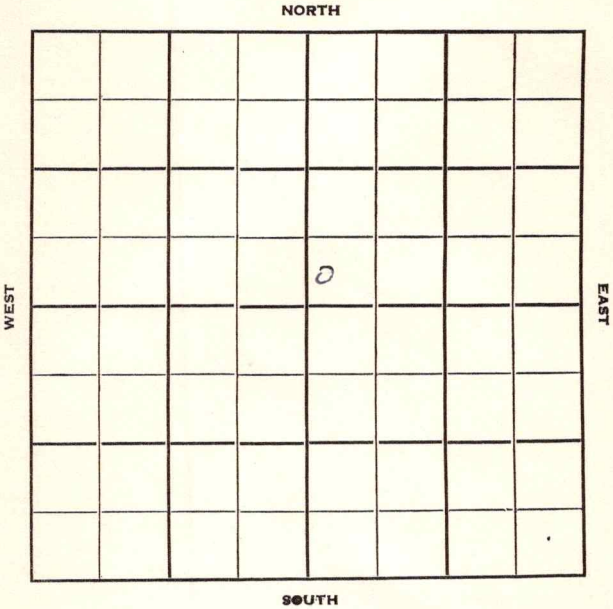

Kearny **KANSAS**
26 R. 37W

Sec. 8 Twp. _____

Well No. #1 Waecher "B" Farm

Stanolind Company

Hugoton Pool Contractor


_____ Ft. from N. Line

300' Ft. from S. Line

_____ Ft. from E. Line

150' Ft. from W. Line

SW NE

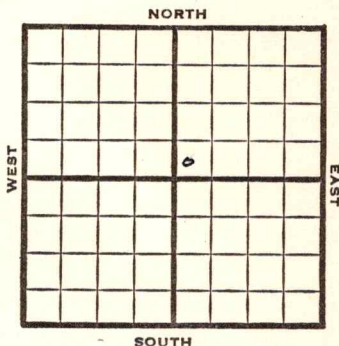

1950

Elev 3150'

REPORT

11/15

Location

1951

1/10

10" @ 607

Her 2412

Win 2470

Ft. Riley 2535

TD 2627

7" @ 2582

132/2416-38

120/2470-90

156/2535-66

31500 A

Comp 13,367,000 gas

Completed

COMPLETED

