


Section 21 Township 26 Range 37WWell No. #1 Coons Gas UnitCompany Stanolind

NORTH

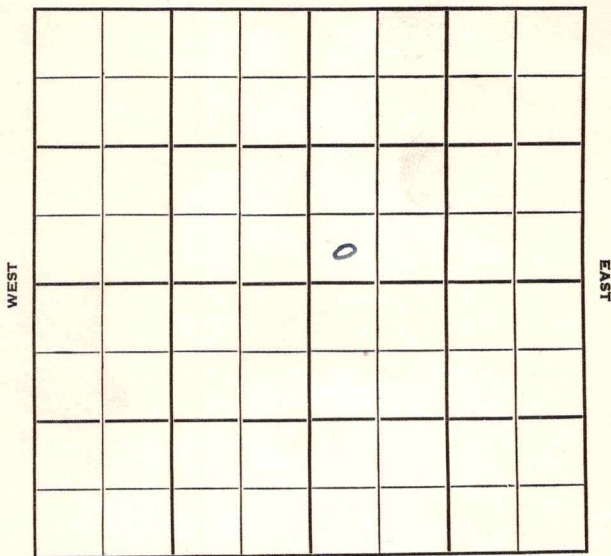

SOUTH

Kearny

KANSAS



Sec. 21 Twp. 26 R. 37W

Well No. #1 Coons Gas Unit Farm

Stanolind Company

Contractor


Ft. from N. Line

150' Ft. from S. Line

Ft. from E. Line

150' Ft. from W. Line

SW NE

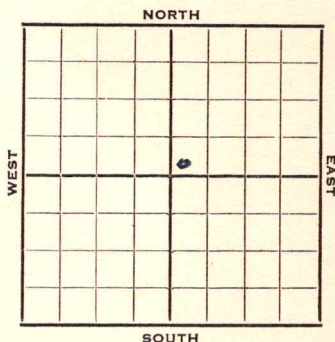

1952

Elev. 3058'

REPORT

9/4

Location

9/10

"

9/17

8" @ 566'

9/24

Her Krider 2346

Winfield 2402

Ft Riley 2510

RTD 2535

5" @ 2510

CO 2535

66/2346-57 36/2359-65

24/2369-73 12/2376-78

36/2385-91 154/2402-33

150/2462-94

10/1

24,000 Total A

10/15

Spud Date: 9-10-52

Drlg. Data: Gas Well TD 2535

8" @ 566

Her-Kri 2346, Win. 2402, Ft. Riley 2510

TD 2535

5" @ 2510

CO to 2535 66/2346-57, 36/2359-65

24/2369-73, 12/2376-78, 36/2385-91,

154/2402-33, 150/2462-94 24000A

Comp. 7,108,000 gas

COMPLETED

County Kearny State KansasSec. 21 (Blk.) 26 (Sur.) 37W Map No.
(Twp.) (Rge.)Operator StanolindWell No. 1 Farm Coons Gas UnitElev. _____ Location SW NE

150 Ft. From S Line NE150 Ft. From W Line Quarter1st. Report SEP 4 1952

Completion _____

Remarks _____

Spudding Date _____

Drlg. Data _____

Location _____

J. G. McGEHEE

County Kearny State Kansas

Sec. 21 (Blk. Twp.) 26 (Sur. Rge.) 37W Map No.

Operator Stanolind

Well No. 1 Farm Coons Gas Unit

Elev.	3058	Location	SW NE
-------	------	----------	-------


150 Ft. From S Line NE

150 Ft. From W Line Quarter

1st. Report

Completion OCT 15 1952

Remarks _____

Spudding Date 9-10-52

Drlg. Data Gas well TD 2535

8" @ 566 Her-Kri. 2346 Win. 2402

Ft. Riley 2510 TD 2535 5" @ 2510

CO. to 2535 66/ 2346-57 36/ 2359-65

24/ 2369-73 12/ 2376-78 36/ 2385-91

154/ 2402-33 150/ 2462-94 24000A

Comp. 7,108,000 gas

J. G. McGEHEE