


Section 10 Township 26 Range 37-WWell No. #2 HillyardCompany Helmerich & Payne
Hugoton Pool

NORTH

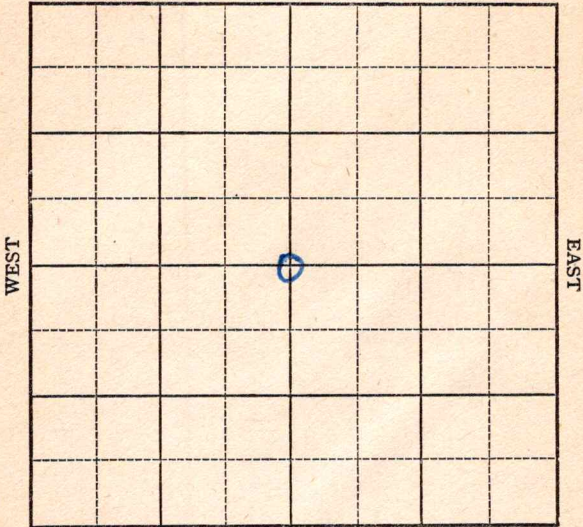

SOUTH

KANSAS

Kearny County

Sec. 10 Twp. 26 R. 37-WWell No. 2 Hillyard Farm
Helmerich & Payne Company

Hugoton Pool


2640 Ft. from N. Line

Ft. from S. Line

2640 Ft. from E. Line

Ft. from W. Line

C Sec.

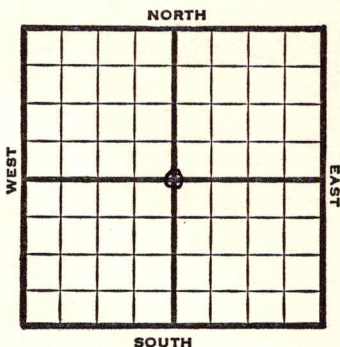

1947 Elev. 3054' REPORT

8/20 RUR

8/27 10" @ 595'
TD 2365'
7" @ 2356'
RUST

9/3 "

9/10 TD 2625'-290' of 5" Perf liner
@ 2625' - 15000 acid

9/17 " "

9/24 " "

10/1 " "

10/8 " "

10/15 " "

10/22 " "

10/29 " "

11/5 " "

11/12 " "

11/19 TD 2625'
Set 290' of 5" Perf. liner
@ 2625'
15,000 Acid

11/25 "

OVER

1947

12/3

7" @ 2356'

290' of 5" Perf. liner @ 2625'

Acid 15,000

Gas 923,000

Rock Pr. 421#

Total Depth 2625'

COMPLETED

Map No. _____ Sec. 10 Twp. 26 R. 37W

Well No. 2 Hilliard

Helmerich & Payne Company

FIRST REPORT Contractor

C Sec.


SECTION PLAT

2640 Ft. from N. Line

_____ Ft. from S. Line

2640 Ft. from E. Line

_____ Ft. from W. Line

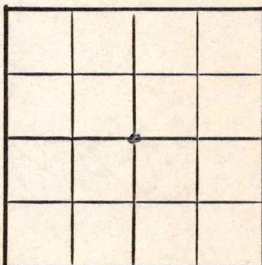

Kearny County

Location _____

Rig up _____

Drilling and Remarks:

R U R

RECORD

Cased _____ in., _____ ft.

Sand _____

Gas _____

Oil _____

Total Depth _____

PRODUCTION

1st 24 hrs. Nat. _____

1st 24 hrs. after shot _____

Gas _____ Cu. Ft.

Dry Hole _____

Abandoned _____

Date

AUG 20 1947

19

S. J. LEWIS

Scout

Map No. _____ Sec. 10 Twp. 26 R. 37W

Well No. 2 Hillyard

Helmerich & Payne Company

COMPLETE

Contractor

C $E\frac{1}{2}$ W $\frac{1}{2}$ Sec.

E113054


SECTION PLAT

2640 Ft. from N. Line

_____ Ft. from S. Line

540 Ft. from E. Line

_____ Ft. from W. Line

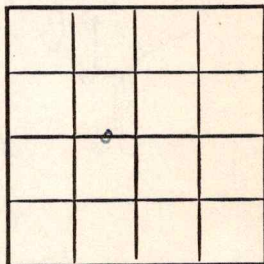

Kearny County

Location _____

Rig up _____

Drilling and Remarks:

7" @ 2356

*290' of 5" Dry hole
@ 2625*

15000 sand

923,000 Gas

#21 #R B2

RECORD

Cased _____ in., _____ ft.

Sand _____

Gas _____

Oil _____

Total Depth 2625

PRODUCTION

1st 24 hrs. Nat. _____

1st 24 hrs. after shot _____

Gas _____ Cu. Ft.

Dry Hole _____

Abandoned _____

Date

DEC 3 1947

19

S. J. LEWIS

Scout