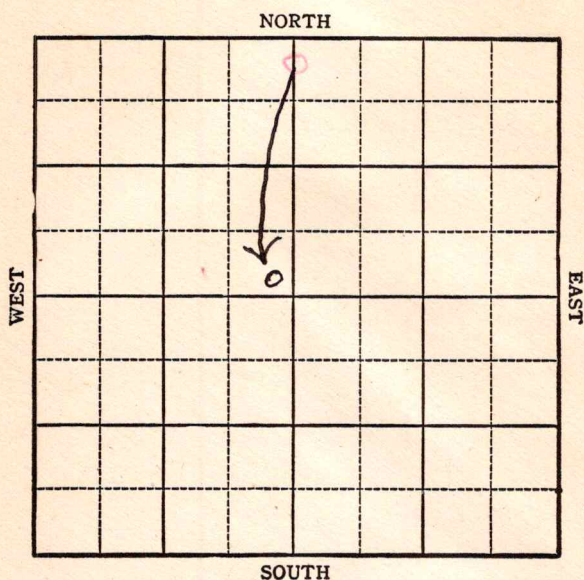


KANSAS

Kearny

Section 11 Township 26 Range 37WWell No. #1 HillyardCompany Helmerick & Payne

KANSAS

Kearny

Sec. 11 Twp. 26 R. 37W

Well No. 1 Hillyard Farm

Helmerick & Payne

Company


Hugoton

~~100~~ Ft. from N. Line

100 Ft. from S. Line

~~1002640~~ Ft. from E. Line

Ft. from W. Line

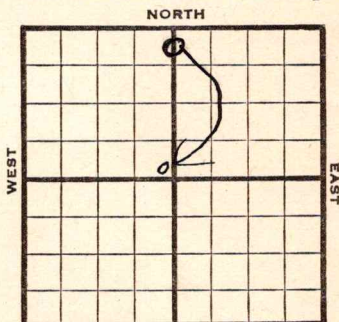

~~GNL~~ Sec SE NW

1944

Elev 3069 R E P O R T

11/22

10" @ 758
1710

11/29

5" : 2636 TD 2798 RUST

12/6

" " " " "

12/14

" " " " "

12/21

" " " " "

12/29

" " " " "

1945

1/3

" " " " "

1/10

14 shots 2600-16 500 acid

1/17

" " " " " "

1/26

25500 acid

1/31

Rip csg. 2652-2658; 2500-2520;
2558-2564; 40 shots 2550-2570;
30 sho s 2406-2420; 30 shots 238
2382-2402 27500 acid

2/7

Esti 35 M gas

2/14

" " " "

2/21

$\frac{1}{2}$ 5" @ 2636
27,500 acid
10,120,000 Gas
TD 2636
432# RP


COMPLETED

KANSAS

Pool Name HugotonMap No. 141N Sec. 11 Twp. 26 R. 37WWell No. 1HillyardHelmerick & Payne CompanyFIRST REPORT Contractor

O N L Sec

SECTION PLAT

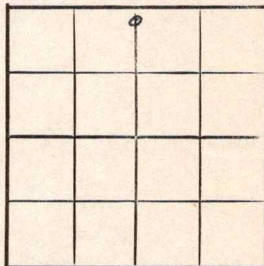100 Ft. from N. Line Ft. from S. Line2640 Ft. from E. Line Ft. from W. LineKearnyLocation Rig up

Drilling and Remarks:

10"-7581710

RECORD

Cased in., ft.Sand Gas Oil Total Depth

PRODUCTION

1st 24 hrs. Nat. 1st 24 hrs. after shot Gas Cu. Ft.Dry Hole Abandoned


Date

NOV 22 1944 19S. J. LEWIS Scout

Pool Name HugotonMap No. NM Sec. 11 Twp. 26 R. 37WWell No. 1 HillyardHelmerick & Payne CompanyCOMPLETED Contractor

SE NW

SECTION PLAT

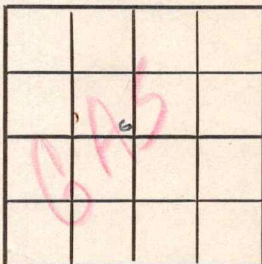 Ft. from N. Line100 Ft. from S. Line100 Ft. from E. Line Ft. from W. Line

Kearny

Location Rig up

Drilling and Remarks:

5-22636
 27,500 acid
 10,120,000 Gas
 432 # R/E

RECORD

Cased in., ft.Sand Gas Oil Total Depth 2636

PRODUCTION

1st 24 hrs. Nat. 1st 24 hrs. after shot Gas Cu. Ft.Dry Hole Abandoned

Date

FEB 21 1945

19

S. J. LEWIS

Scout