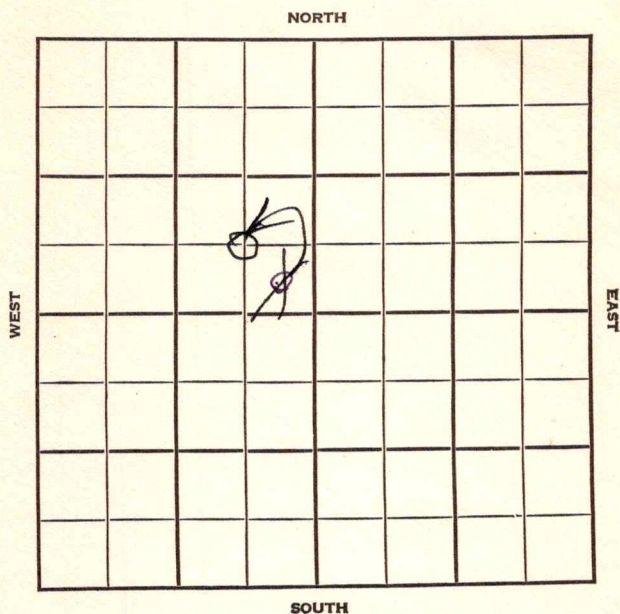


Section 14 Township 26 Range 37-WWell No. #5 HillyardCompany Helmerich & Payne

Kearny

Sec. 14 **KANSAS** Twp. 26 R. 37 W

Well No. #5 Hillyard Farm

Helmerich & Payne Company

Hugoton Pool


 Ft. from N. Line

660
~~330~~ Ft. from S. Line

660
~~330~~ Ft. from E. Line

 Ft. from W. Line

C SE NW

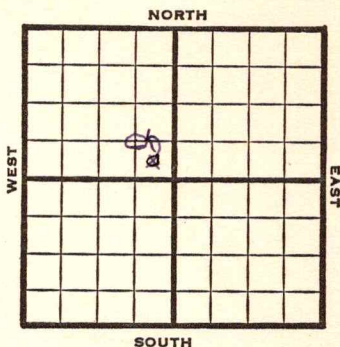

1948

Elev. 3078'

R E P O R T

7/14	10" @ 755'
	Drlg. 800'
7/21	TD 2389'
	7" @ 2388'
7/28	"
8/4	"
8/11	TD 2420' 3000 acid
8/18	2598 12000 acid
8/25	"
9/1	"
9/8	7" @ 2388'
	TD 2420'
	Acid 15,000
	245' of 5" Perf liner @ 2420
	Gas 24,840,000
	R. Pr. 405#

COMPLETED

Map No. _____ Sec. 14 Twp. 26 R. 37W

Well No. 5 Hillyard

Helmerich & Payne Company

CORRECTION Contractor

C SE NW

SECTION PLAT

	o		

_____ Ft. from N. Line

660 Ft. from S. Line

660 Ft. from E. Line

_____ Ft. from W. Line

Kearny County

Location _____

Rig up _____

Drilling and Remarks:

Reported

SE NW

RECORD

Cased _____ in., _____ ft.

Sand _____

Gas _____

Oil _____

Total Depth _____

PRODUCTION

1st 24 hrs. Nat. _____

1st 24 hrs. after shot _____

Gas _____ Cu. Ft.

Dry Hole _____

Abandoned _____

Date

JUL 21 1948

19

S. J. LEWIS

Scout

Kearny County Kansas State

Map No. _____ Sec. 14 Twp. 26 R. 37W

Well No. 5 Hillyard

Helmerich & Payne Company

COMPLETE Contractor

C SE NW


E. 308
SECTION PLAT

_____ Ft. from N. Line

660 Ft. from S. Line

660 Ft. from E. Line

_____ Ft. from W. Line

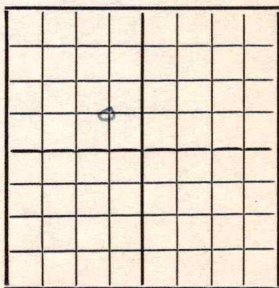

Hugoton Pool

Remarks:

7 "C2388

7.52420

1500000000

245' of 15" Perf liner @ 2420

24.840,000 Gall

400# R₂

Date
SEP 8 1948

Scout
S. J. LEWIS

Map No. _____ Sec. 14 Twp. 26 R. 37W

Well No. 5 Hillyard

Helmerich & Payne Company

FIRST REPORT

Contractor

SE NW

SECTION PLAT

_____ Ft. from N. Line


330

_____ Ft. from S. Line

330

_____ Ft. from E. Line

_____ Ft. from W. Line

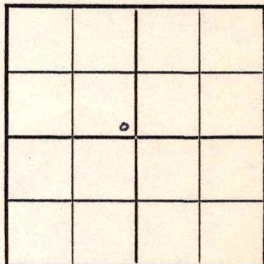

Kearny Cou ty

RECORD

Location _____

Cased _____ in., _____ ft.

Rig up _____

Sand _____

Drilling and Remarks:

Gas _____

10" @ 755

Oil _____

drlg. 800

Total Depth _____

PRODUCTION

1st 24 hrs. Nat. _____

1st 24 hrs. after shot _____

Gas _____ Cu. Ft.

Dry Hole _____

Abandoned _____

Date

JUL 14 1948

19

S. J. LEWIS

Scout